


T.28S.R.14W.W.M.

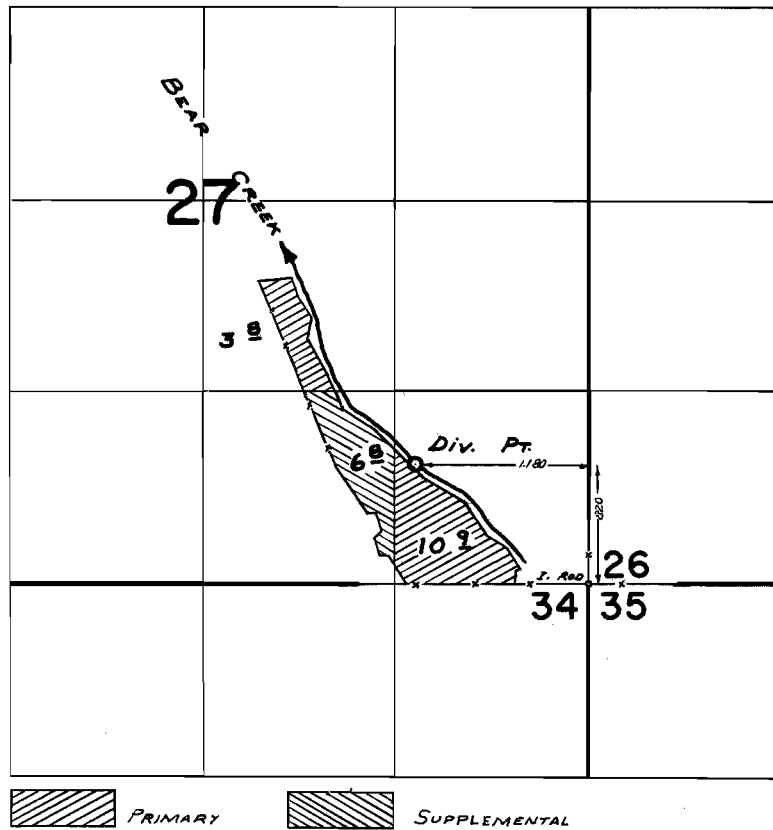

FINAL PROOF SURVEY
UNDER

Application No. 41054... Permit No. 30639...
IN NAME OF

GLADYS O. PHILPOTT

Surveyed MAY 16 1968, by W. RUPPERT.