


T. 26 S., R. 12 W., W. M.

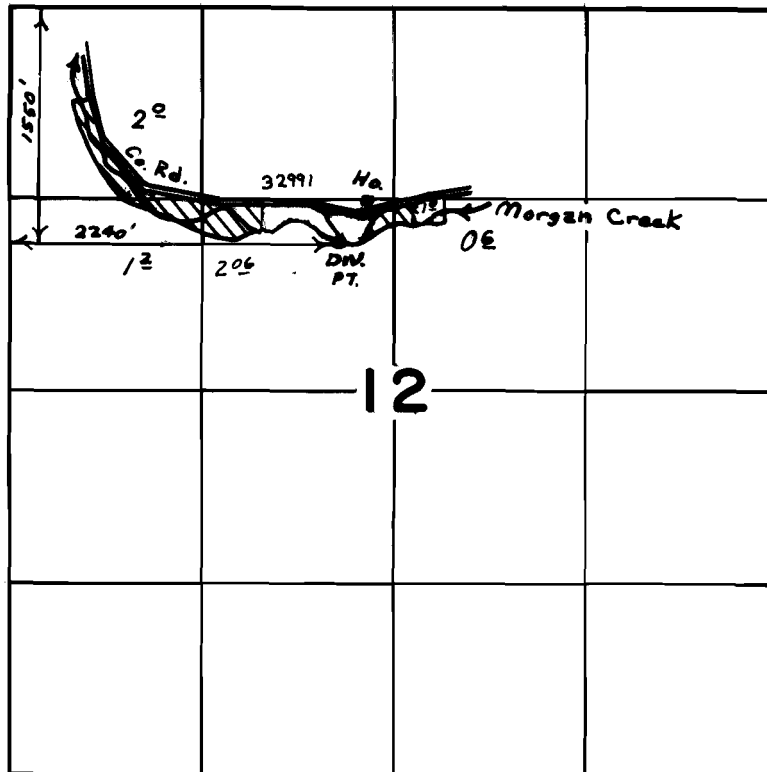

SCALE : 4" = 1 mile

FINAL PROOF SURVEY UNDER

Application No. 54831.... Permit No. 41135....
IN NAME OF

.....CLARENCE.....F.....JACOBSON.....

Surveyed AUG. 9, 1979, by S. DONALDSON