


T.28S.,R.8W.,W.M.

SECTION 36

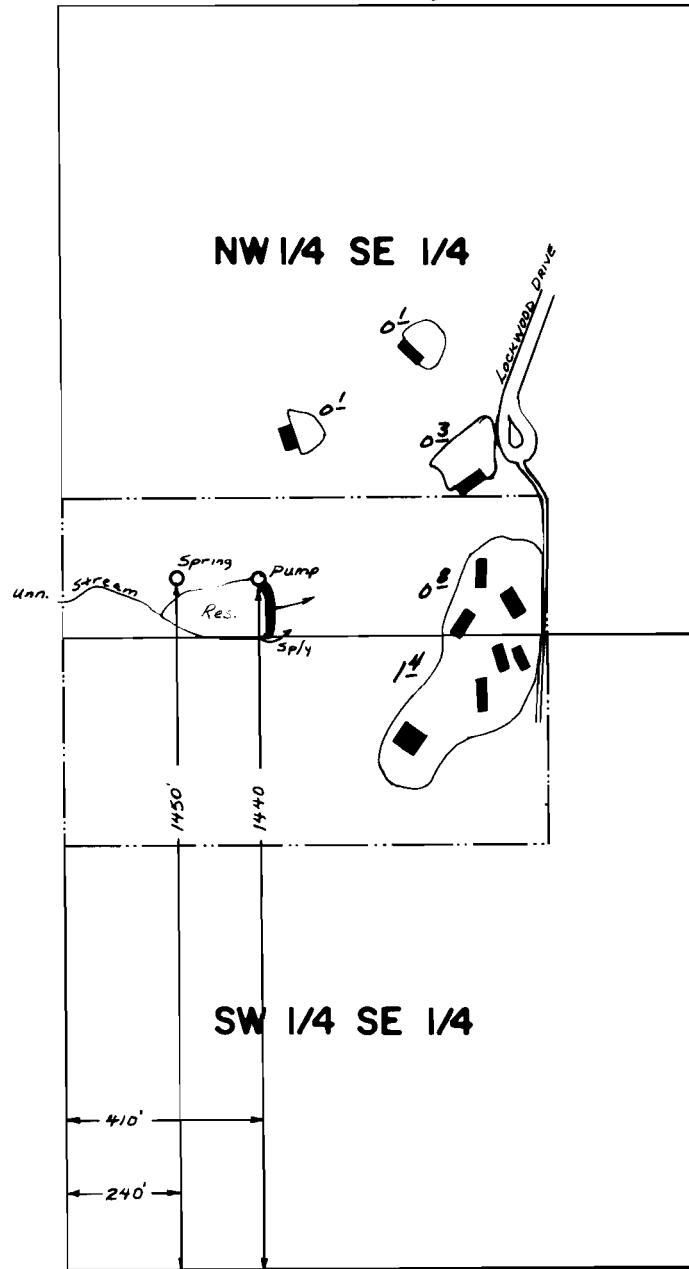

SCALE: 1" = 400'

FINAL PROOF SURVEY

UNDER

R-52256 R-6295
Application No. 52257 Permit No. 39327
IN NAME OF

DOUGLAS LEE CROY

Surveyed April 8, 1980, by J.S. DONALDSON.
Re- " August 17, 1983 by J. S. Donaldson