


T. 30 S., R. 5 W., W.M.

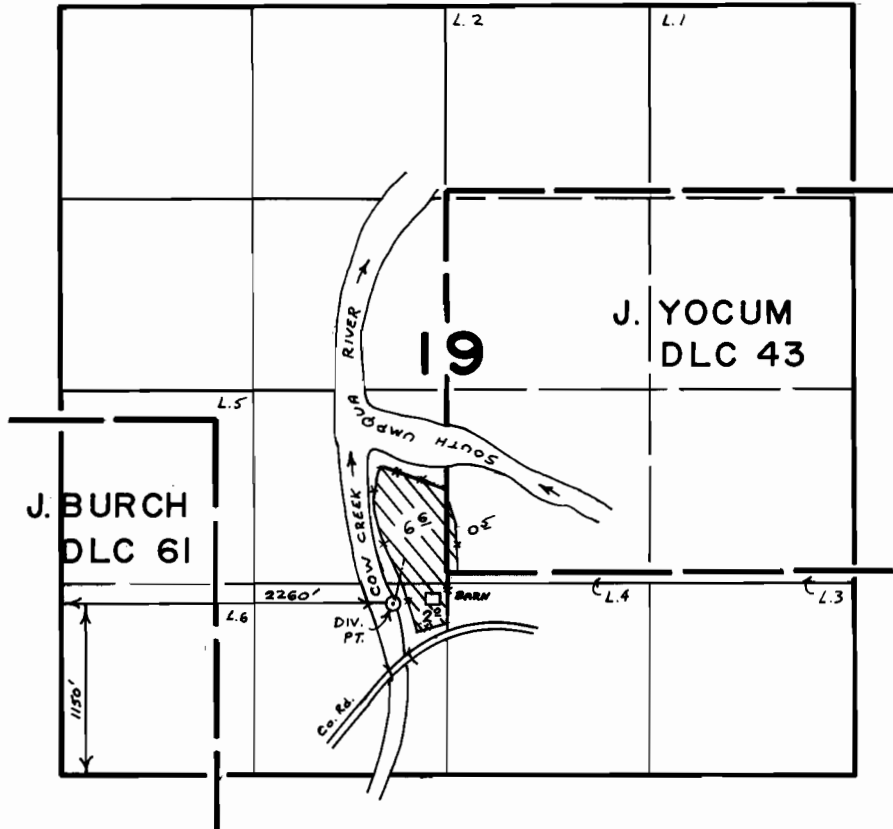

SCALE 4" = 1 mile

FINAL PROOF SURVEY UNDER

Application No. 50965.. Permit No. 38472..
IN NAME OF

WILLIAM B. & ELAINE M. STROBRIDGE

Surveyed Oct. 25, 1979, by S. Donaldson..