


T.28S.,R.7W.,W.M.

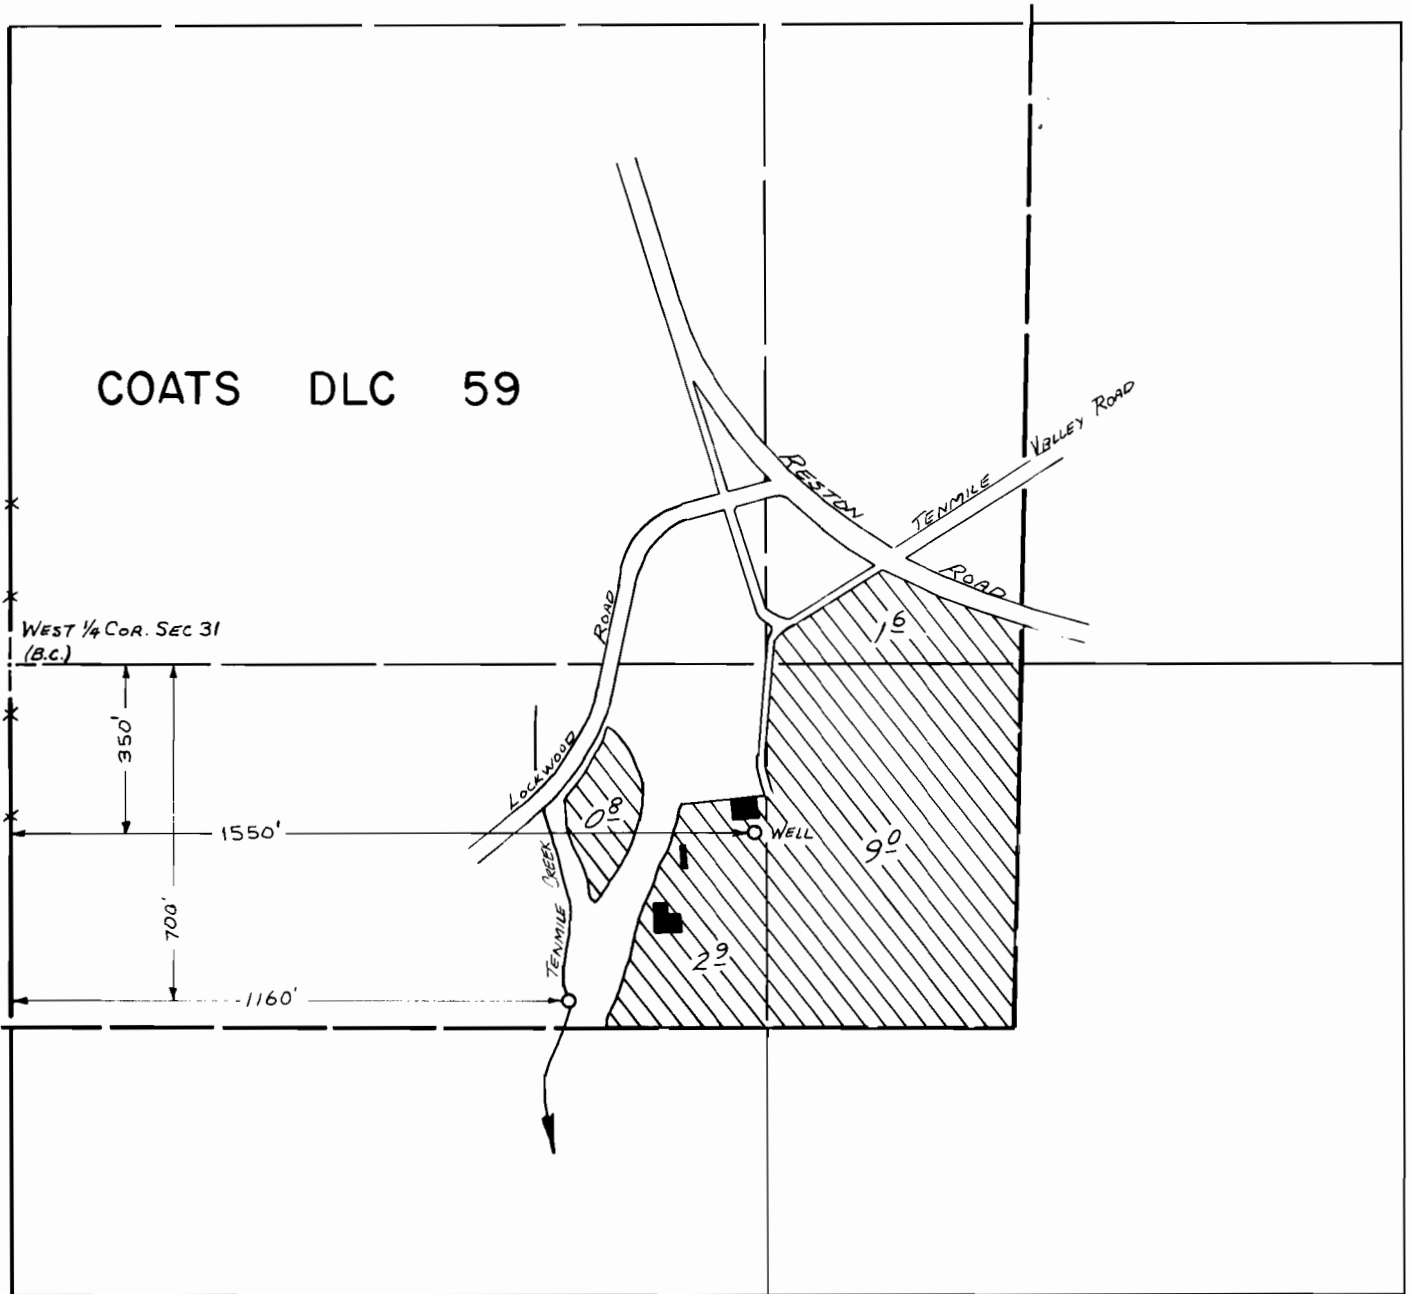

SCALE: 1" = 400'

FINAL PROOF SURVEY

UNDER

Application No. 58577 G-9212 Permit No. 44295 G-8612 Primary Supplemental

IN NAME OF

RONALD WILLIS

Surveyed April 8, 1980, by J.S. DONALDSON
Nov 11 1982 D. R. HENRY