


T.27S.,R.35E.,W.M.

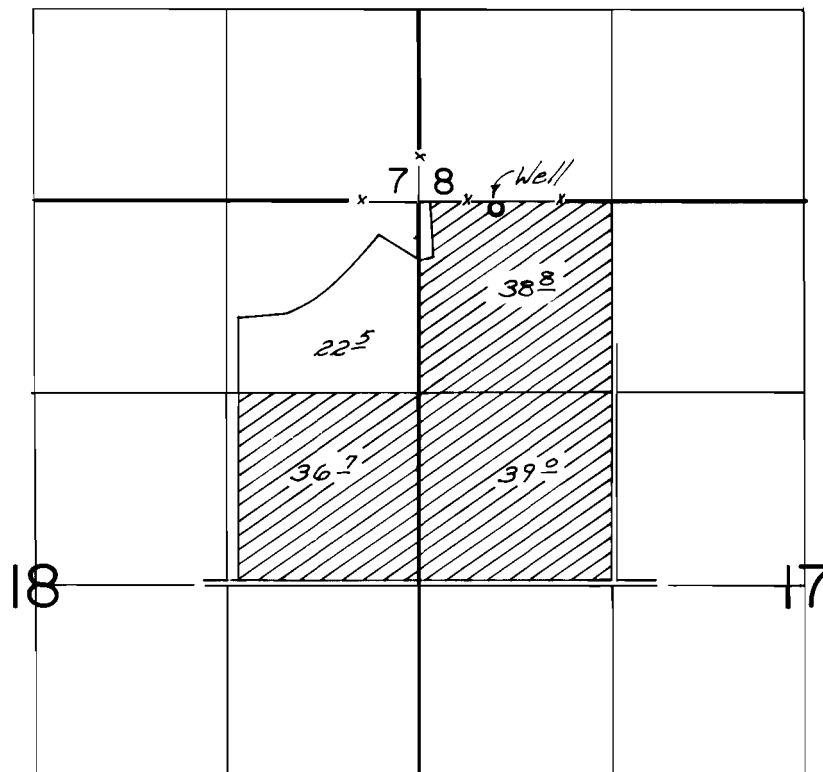

Well Loc: 30' S. & 540' E. from the NW Corner Section 17

FINAL PROOF SURVEY
UNDER

Application No. G-7921 Permit No. G-7312
IN NAME OF

M. M. DAVIES

Surveyed AUG. 26, 1979, by R. G. MUCKEN