


T. 38S., R. 4 W., W.M.

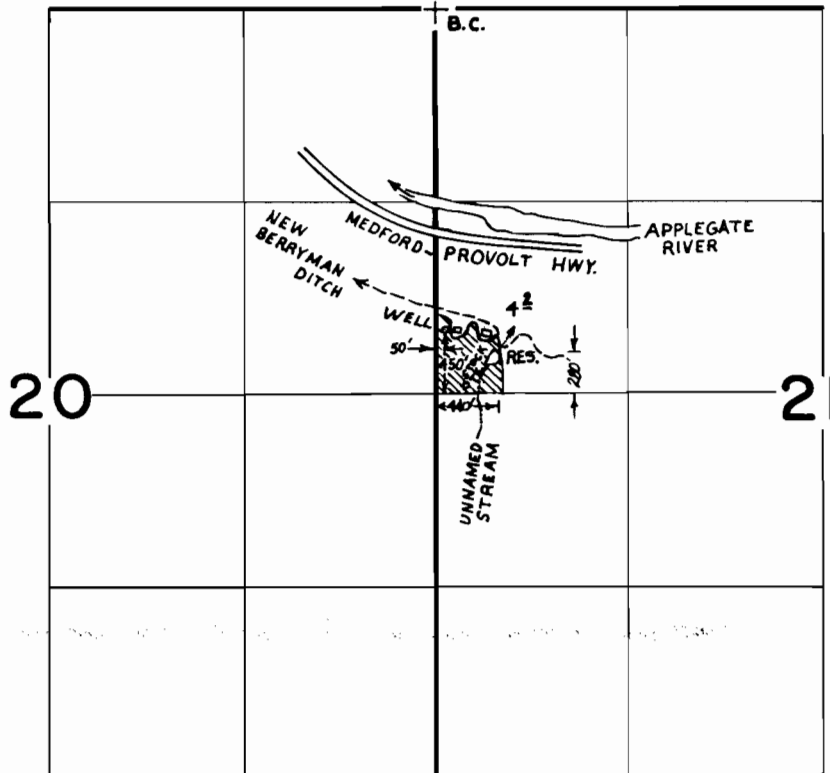

**FINAL PROOF SURVEY**

UNDER

R-58610

R-7919

58611

44366

Application No. G-9222 Permit No. G-8627

IN NAME OF

**BJORN J. JAEGER**

Surveyed JULY 16, 1982, by B. S. JAMES

SCALE: 4" = 1 MILE