


T. 39 S., R. 4 W., W.M.

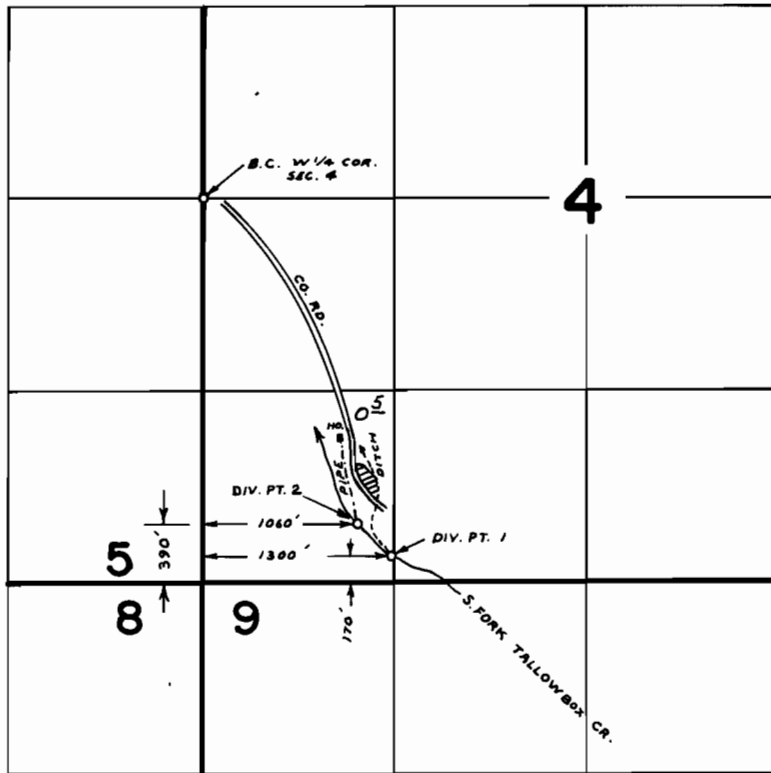

FINAL PROOF SURVEY
UNDER

Application No. 47484 Permit No. 35794

IN NAME OF
CHARLES A. WETLESEN

Surveyed FEB. 7 1980 by B. SUND