


T. 38 S., R. 4 W., W.M.

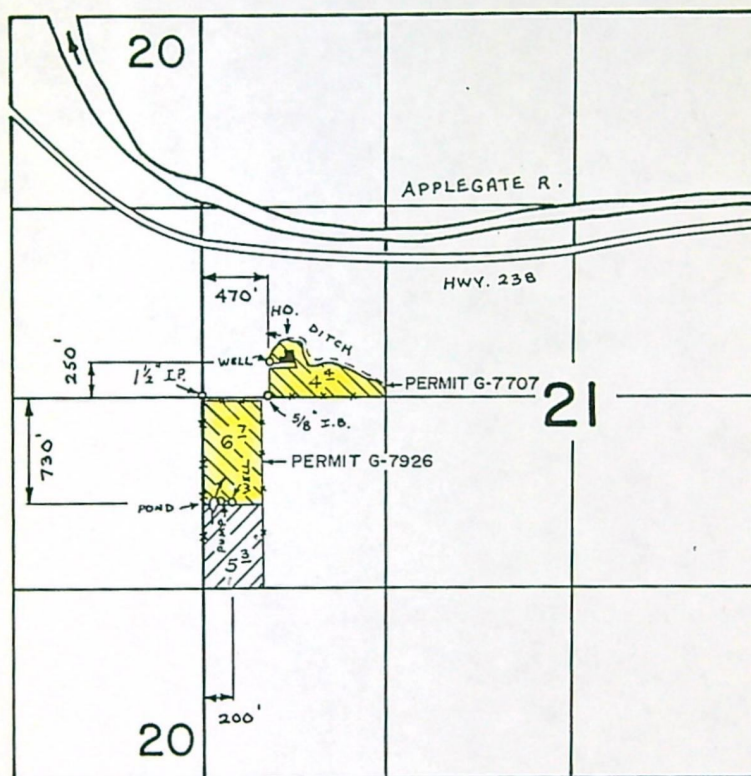

PRIMARY SUPPL.

FINAL PROOF SURVEY
UNDER

62022

45943

G-8305

G-7707

Application No. G-8569 Permit No. G-7926

IN NAME OF

ALVIN D. &/OR EDNA E. WOODRIFF

Surveyed OCT. 12 1978, by B. SUND

D.H.M.
P.T.S. - 1978-14-D