


T.13S., R.9E., W.M.
Section 15

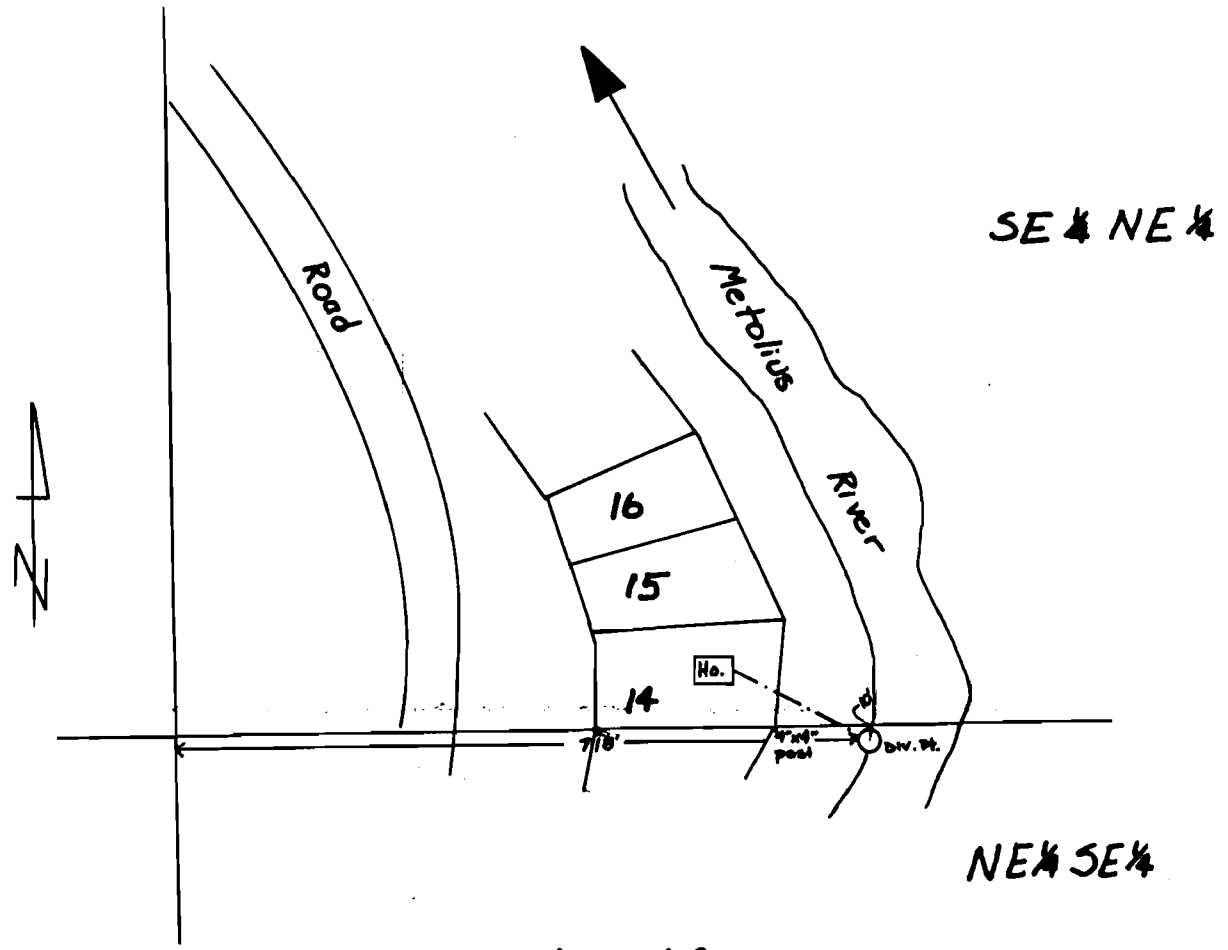

Lot 14, Tract C,
Camp Sherman Summer Homes

SCALE: 1"=200'

FINAL PROOF SURVEY
UNDER

Application No. 63528 Permit No. 47079

IN NAME OF

DAVID P. ROBINS C. 52049

Surveyed OCT. 17, 1983. by D. PANTHER

47079
Chain Survey L60