


T.13S., R. 9E., W.M.

Section 3

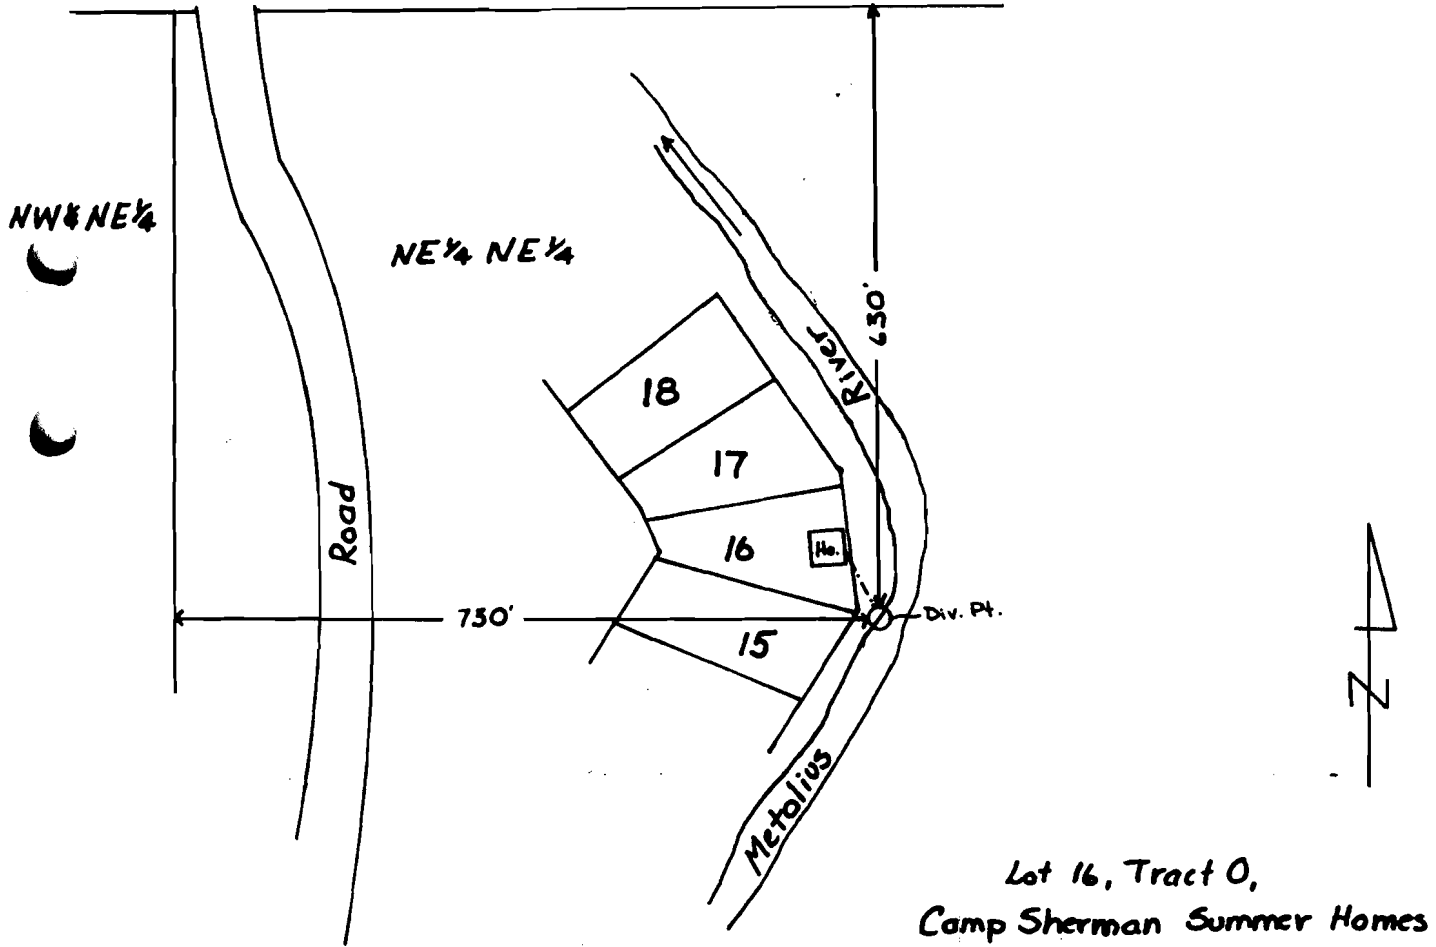

SCALE: 1"=200'

### FINAL PROOF SURVEY

UNDER

Application No. 63483 Permit No. 47151 C. 52050

IN NAME OF

GLENN W. & VERA E. ROSENBERG

Surveyed OCT. 17, 1983, by D. PANTHER

47151  
Chain Survey 160