


T.35 S., R.5 W., W.M.

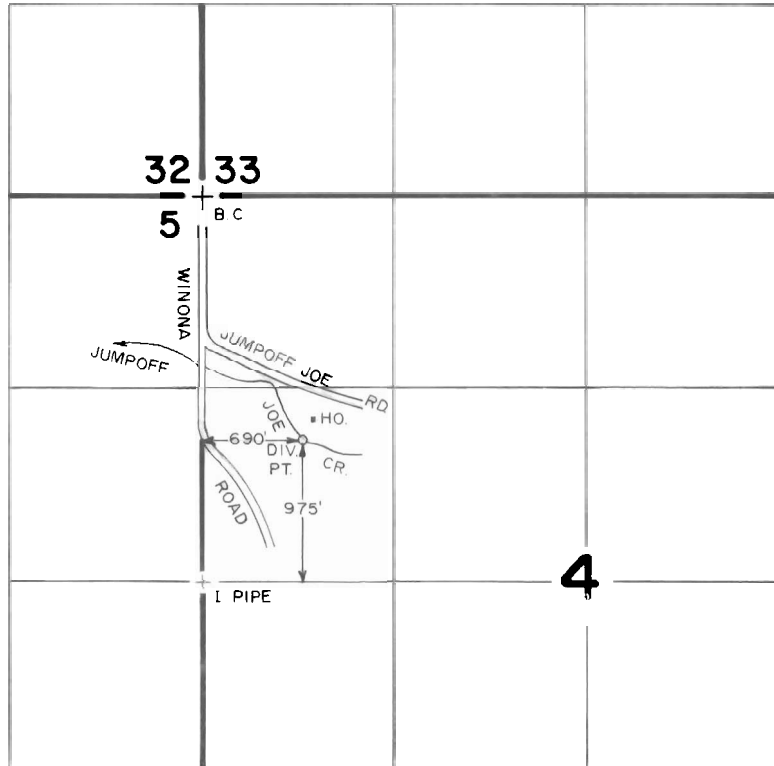

**FINAL PROOF SURVEY**  
UNDER

Application No. 52136 Permit No. 39267  
IN NAME OF

ROBERT M. LOBNOW

Surveyed SEPT. 14 1982, by B. S. JAMES

SCALE: 4" = 1 MILE