


T. 39 S., R. 5 W., W. M.

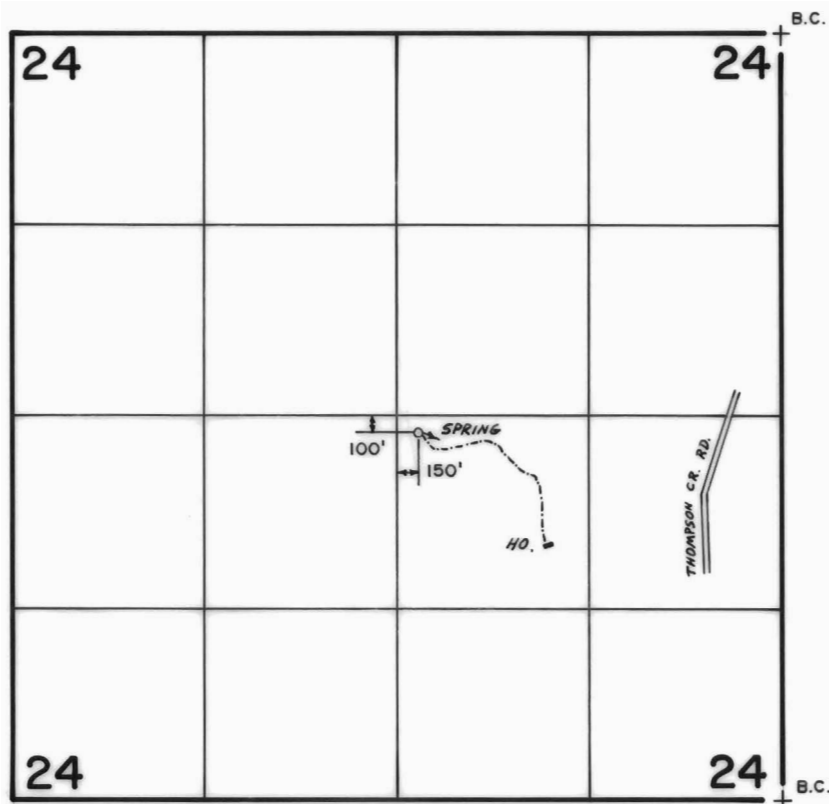

FINAL PROOF SURVEY
UNDER

Application No. **58324**. Permit No. **44015**.....
IN NAME OF

FLORENCE.....BROSS.....EATON.....

Surveyed **May..13,.. 1982**, by **B.R.SUND**.....

SCALE : 4" = 1 Mile