


T.35S., R.5W., W.M.

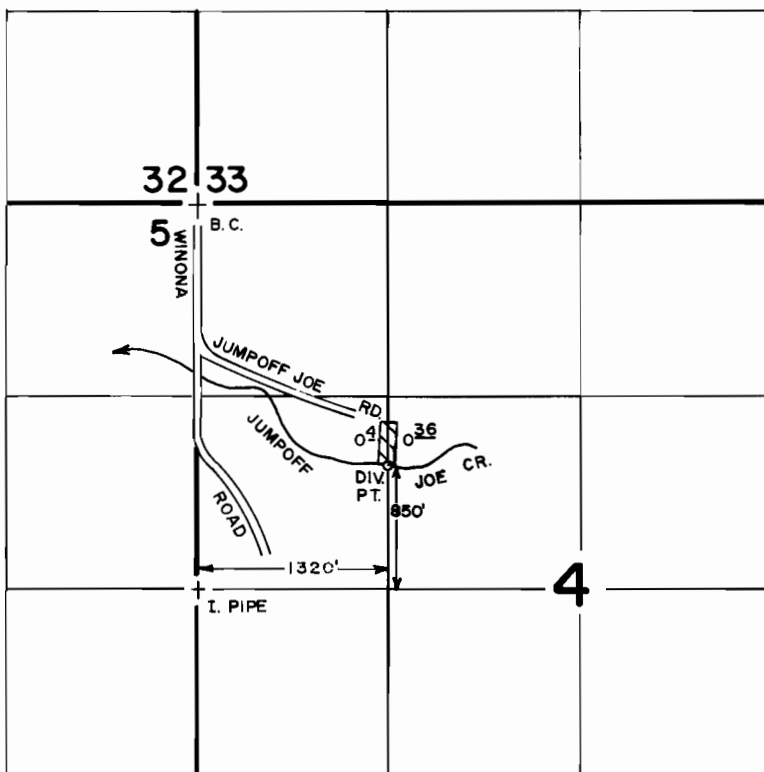

FINAL PROOF SURVEY
UNDER

Application No. 61794 Permit No. 46241
IN NAME OF

Wm. C. PERRY

Surveyed SEPT. 14 1982, by B. S. JAMES

SCALE: 4" = 1 MILE