


T. 35 S., R. 6 W., W.M.

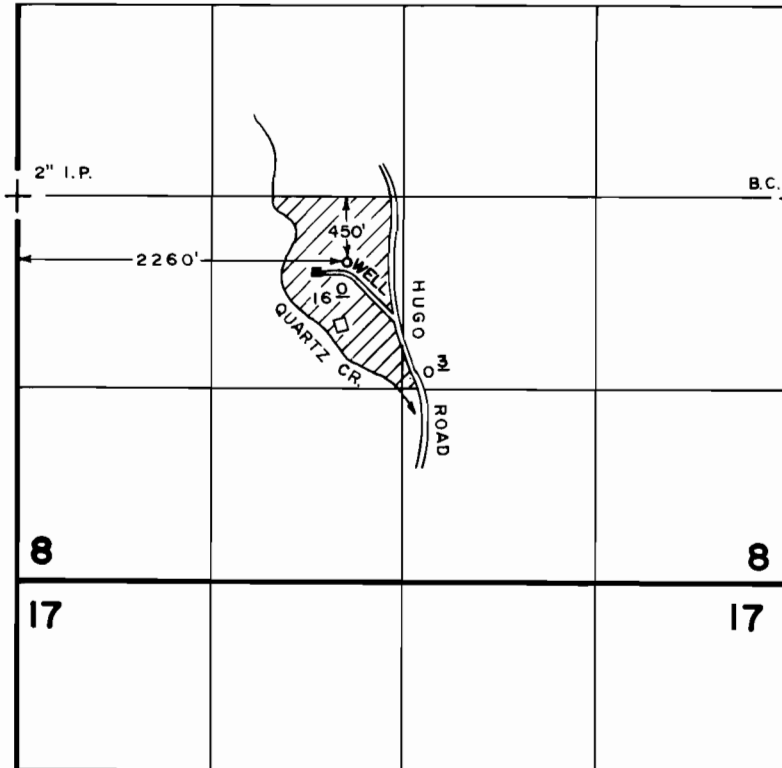

FINAL PROOF SURVEY
UNDER

Application No. **G-8356** Permit No. **G-7777**
IN NAME OF

WESLEY O. DENISON

Surveyed **SEPT. 28 19. 82**, by **B. SUZIE JAMES**.

SCALE: **4" = 1 MILE**