


T. 34 S., R. 6 W., W.M.

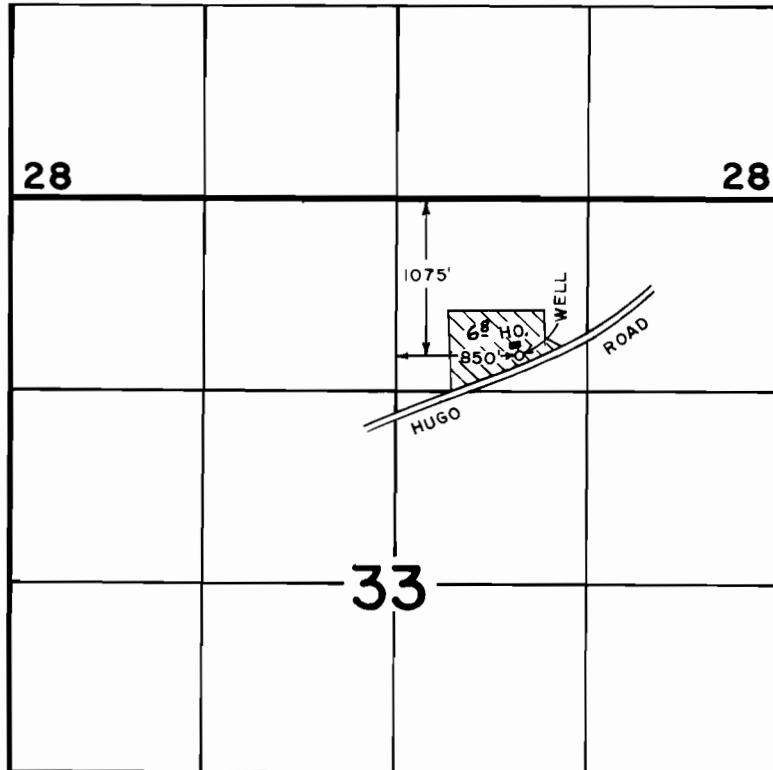

FINAL PROOF SURVEY
UNDER

Application No. G-8631 Permit No. G-8001
IN NAME OF

JEROME G. HATFIELD

Surveyed SEPT. 15 19. 82, by B. SUZIE JAMES

SCALE: 4" = 1 MILE