


T.41S., R.9&10E., W.M.

Klamath Av. wells

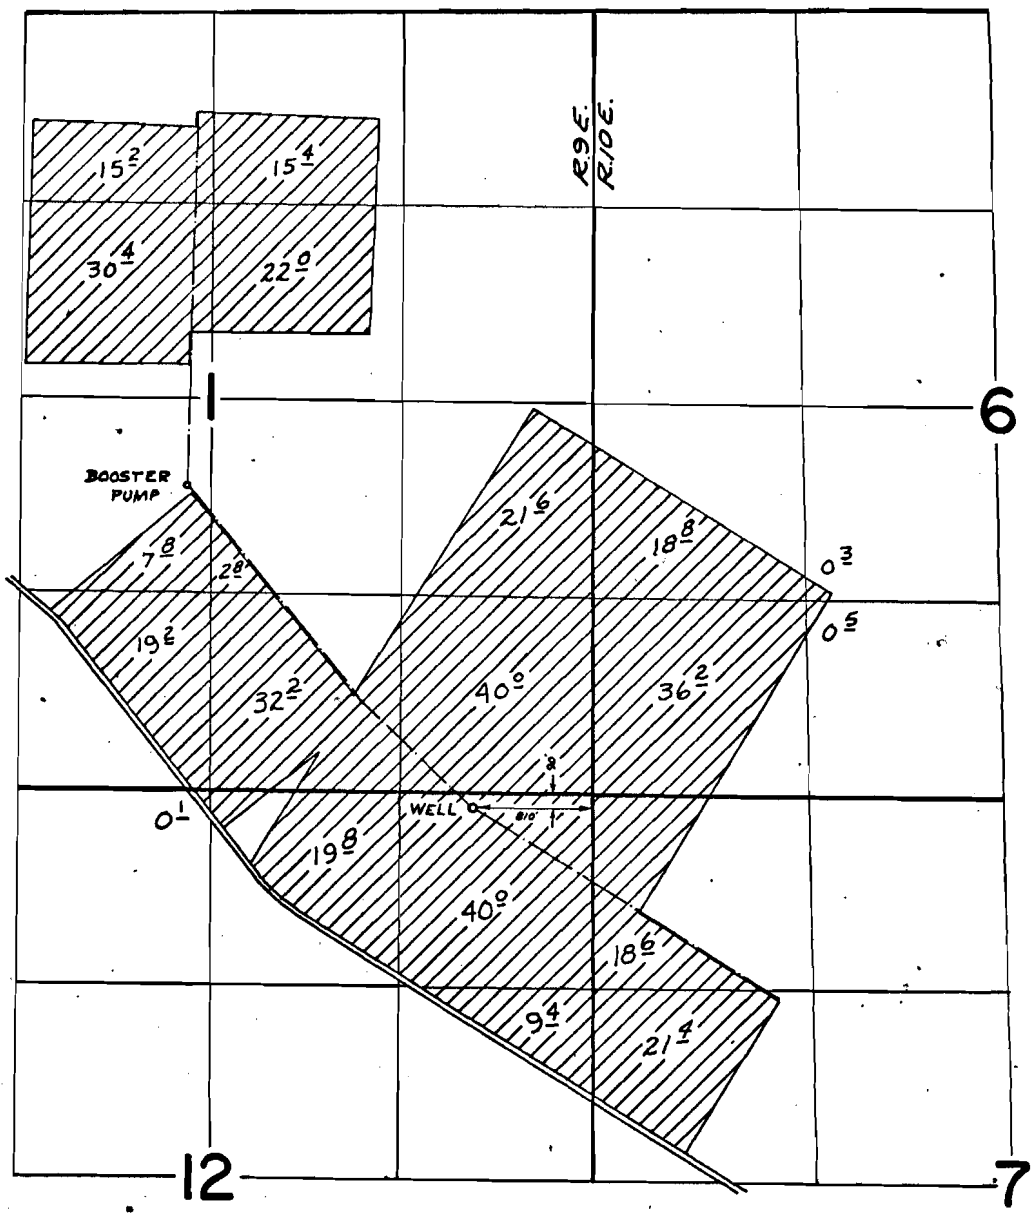

FINAL PROOF SURVEY UNDER

Application No. G-4861 Permit No. G-4578
IN NAME OF

O'CONNOR LIVESTOCK COMPANY

Surveyed Oct. 30 1974, by D.M.Norby