


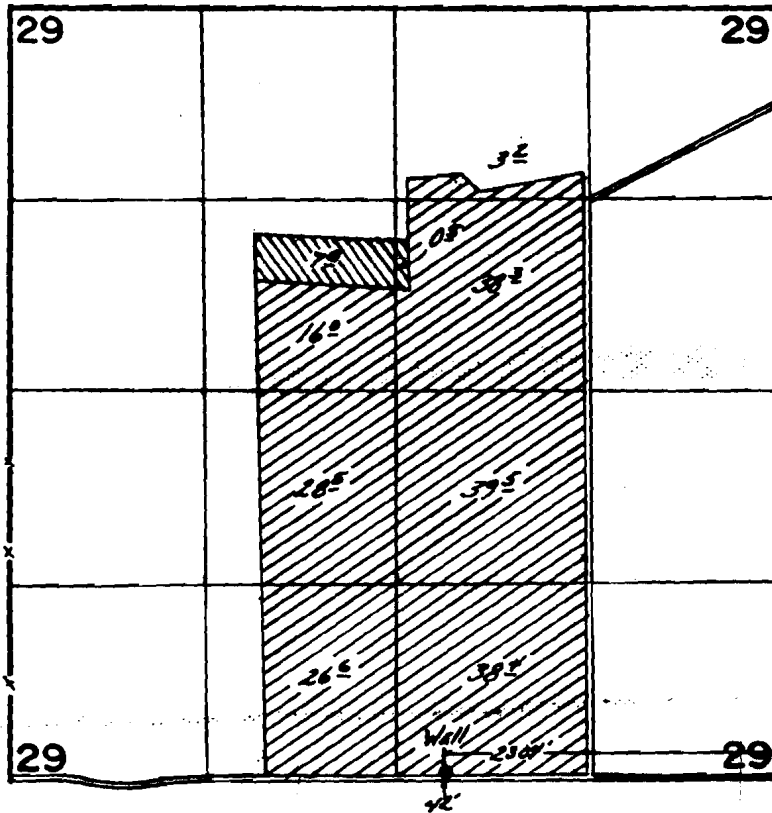

T. 40S.R. 11E.W.M.



 Primary
 Supplemental

FINAL PROOF SURVEY UNDER

Application No. G-7067 Permit No. G-6544....
IN NAME OF

J. RANDALL POPE

Surveyed Sept. 25 1979., by C.R. RODRIGUEZ.