
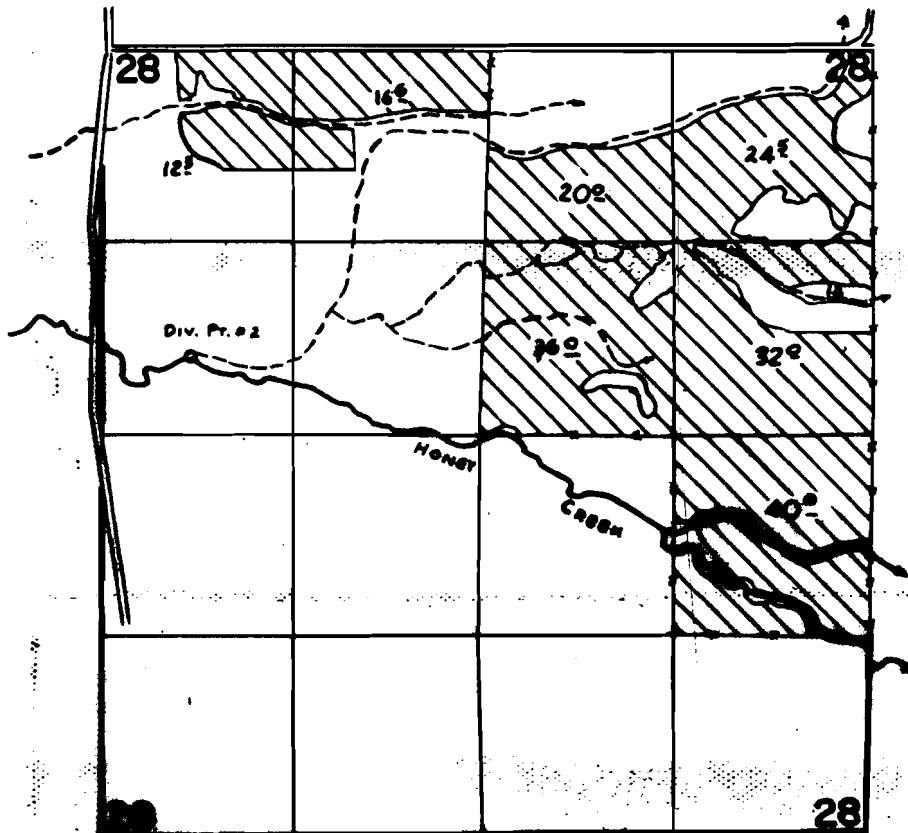


R 655
38384
52062

T36S. R24E. WM.

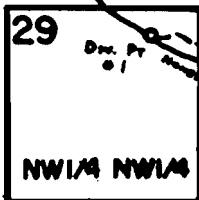

Div. Prs. Loc: #1 - 180'S & 90' E. fr. NW Cor. Sec. 29.
#2 - 2090'S & 610' E. fr. NW Cor. Sec. 28.

FINAL PROOF SURVEY UNDER

Application No. 50838 Permit No. 38384
IN NAME OF
FITZGERALD RANCH INC.

Surveyed JUNE 27 1978, by C. L. HUGHES.