


G-6891
52063

T.28S. R.15E. W.M.

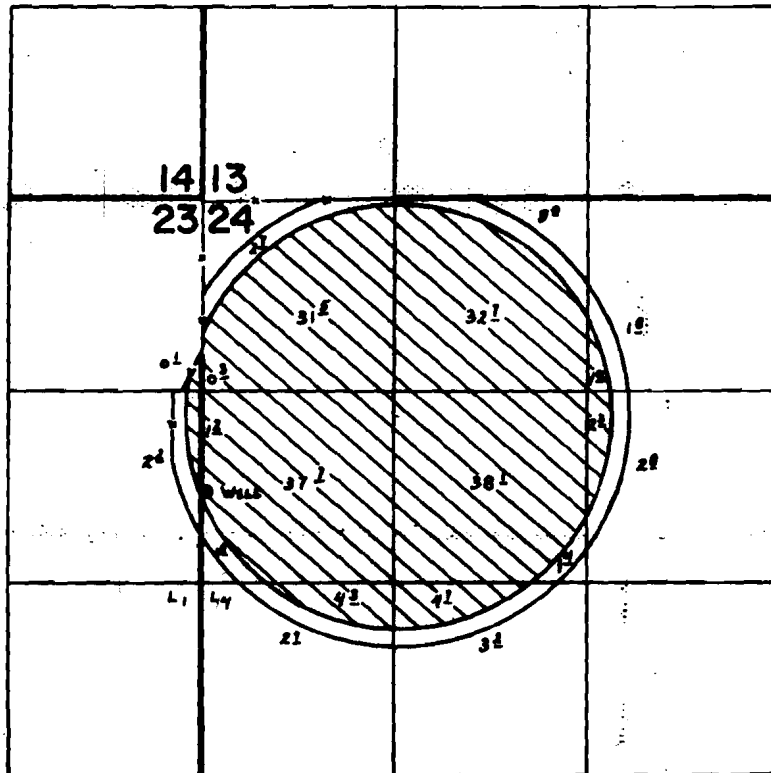

WELL LOC: 630' N. & 30' E. fr. W 1/4 COR. SEC. 24.

FINAL PROOF SURVEY UNDER

Application No. G-7331. Permit No. G-6891....
IN NAME OF

.....CARLON CATTLE CO.....

Surveyed Aug. 28, 1979, by G. L. HUGHES.....