


T.16S., R.2E., W.M.

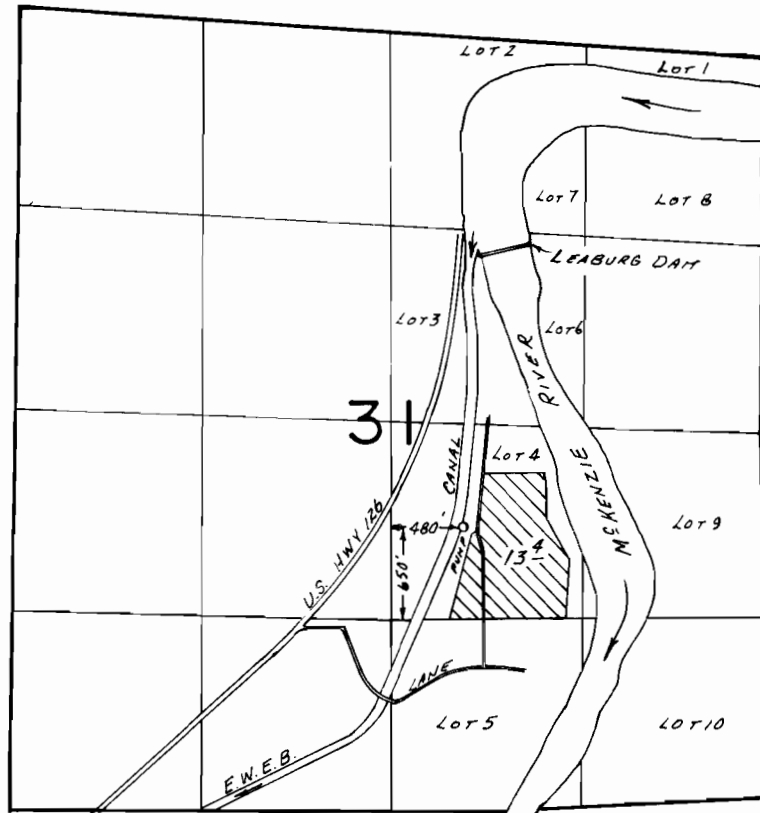

**FINAL PROOF SURVEY**  
UNDER

Application No. 52018... Permit No. 39208....  
IN NAME OF

JACK O. & JOANNA S. MCKINNEY

Surveyed Sept. 11... 1979., by C.L. HUGHES....