


T.12S. R.1W. W.M.

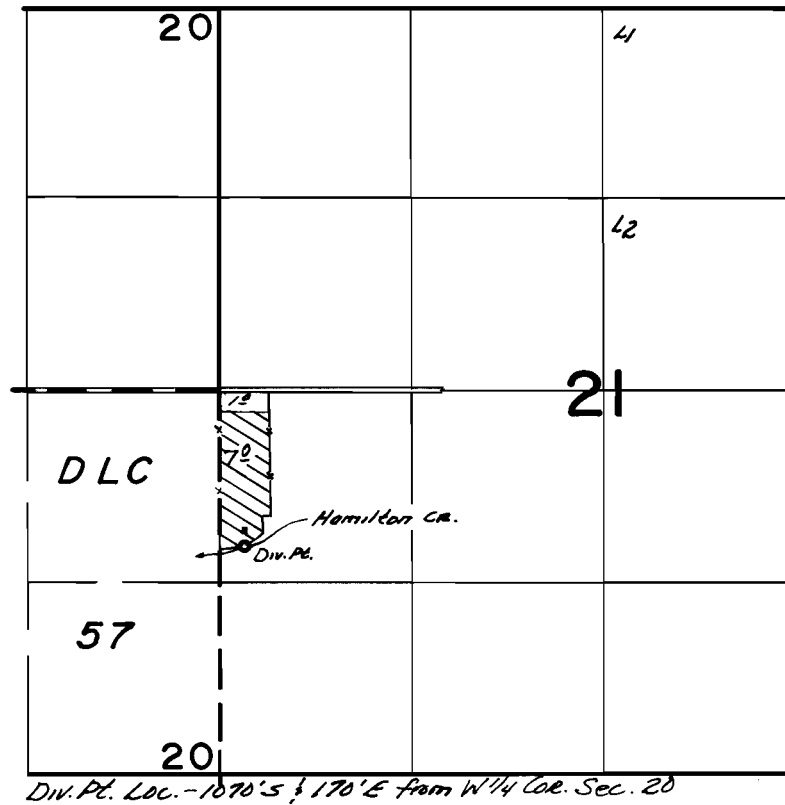

FINAL PROOF SURVEY
UNDER

Application No. **53074** Permit No. **38571**.....
IN NAME OF

.....**JOYCE N. MARTINAK**.....

Surveyed July...**31**.. 1979., by **S.C.BROWN**.....