


T. 1 S., R. 4 W., W.M.

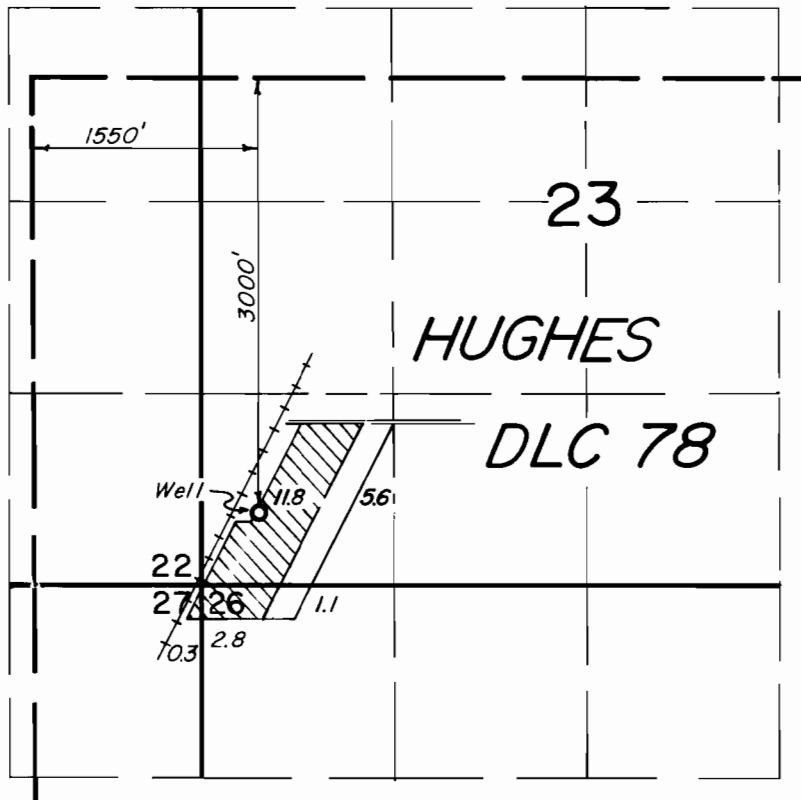

FINAL PROOF SURVEY UNDER

Application No. G-6818 Permit No. G-6318

IN NAME OF

ROBERT J. CLAIR

Surveyed APR. 24, 1979, by *d.l. Brown*