


T.17S. R.44E. W.M.

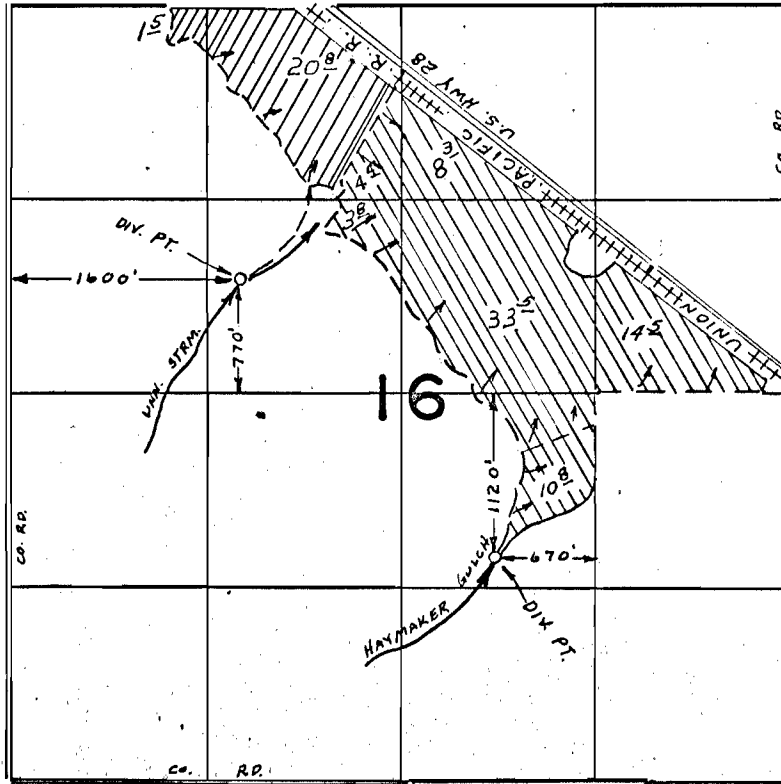

SOURCE: UNNAMED STREAM /////
HAYMAKER GULCH /////

FINAL PROOF SURVEY
UNDER

Application No. 37089 33230
 37090 Permit No. 33231

IN NAME OF
ESTATE OF
J. E. CULBERTSON

Surveyed JUN 27 1974, by L. H. NUNN