


T.6S., R.1E., W.M.

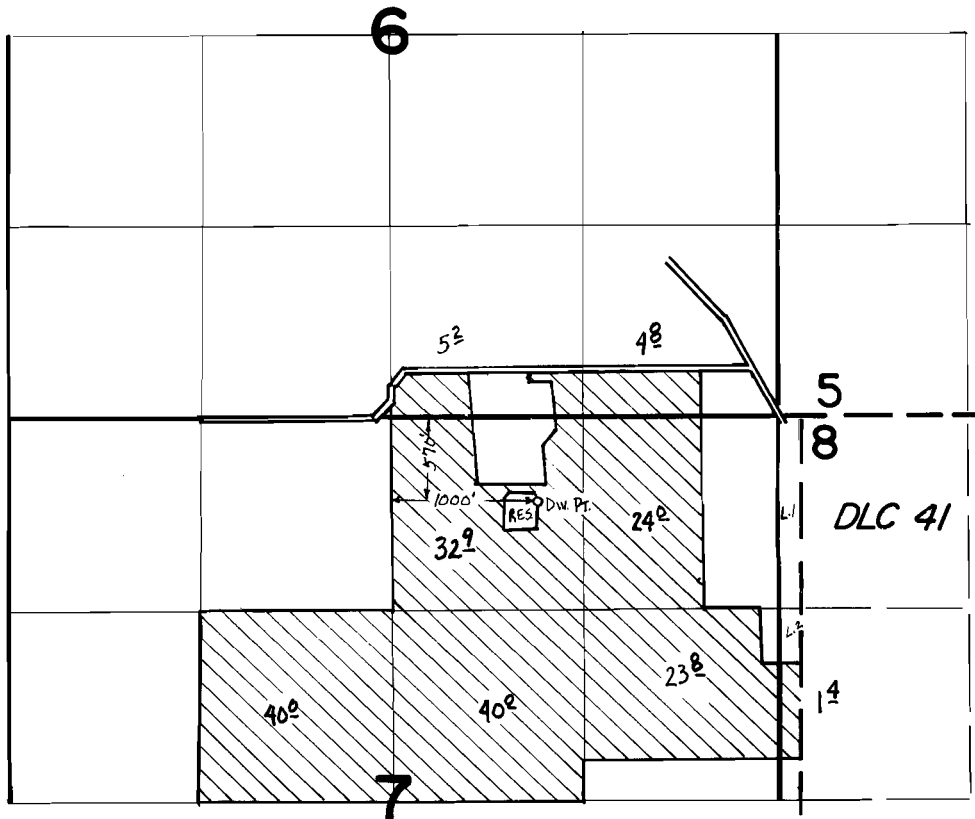

FINAL PROOF SURVEY UNDER

57694 45013
Application No. R57693. Permit No. R.8165.....
IN NAME OF

ARIE JONGENEEL

Surveyed NOV...7... 1983., by .M..CAHILL.....