


T.5&6S. R.1W., W.M.

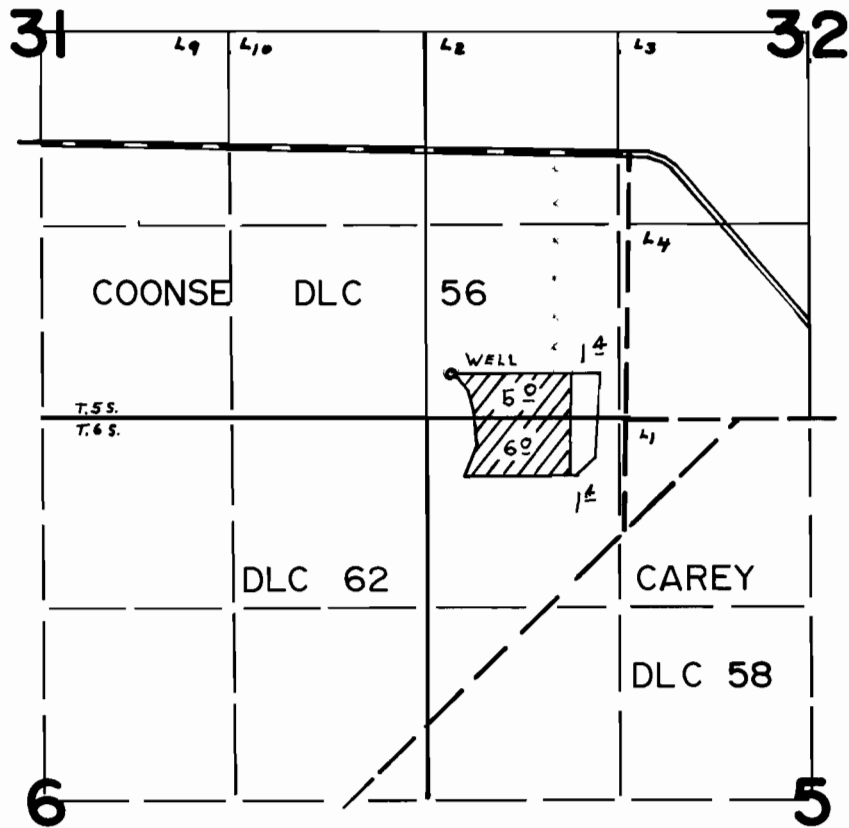

WELL Loc. 1400' S. & 1240' W. FROM N.E. COR. DLC 56

FINAL PROOF SURVEY UNDER

Application No. G-7583... Permit No. G-7140...
IN NAME OF

GEORGE KUSCHNICK

Surveyed JUNE 7, 1979, by L. H. NUNN