


TOWNSHIP 3 NORTH, RANGE 26 & 27 EAST, W. M.

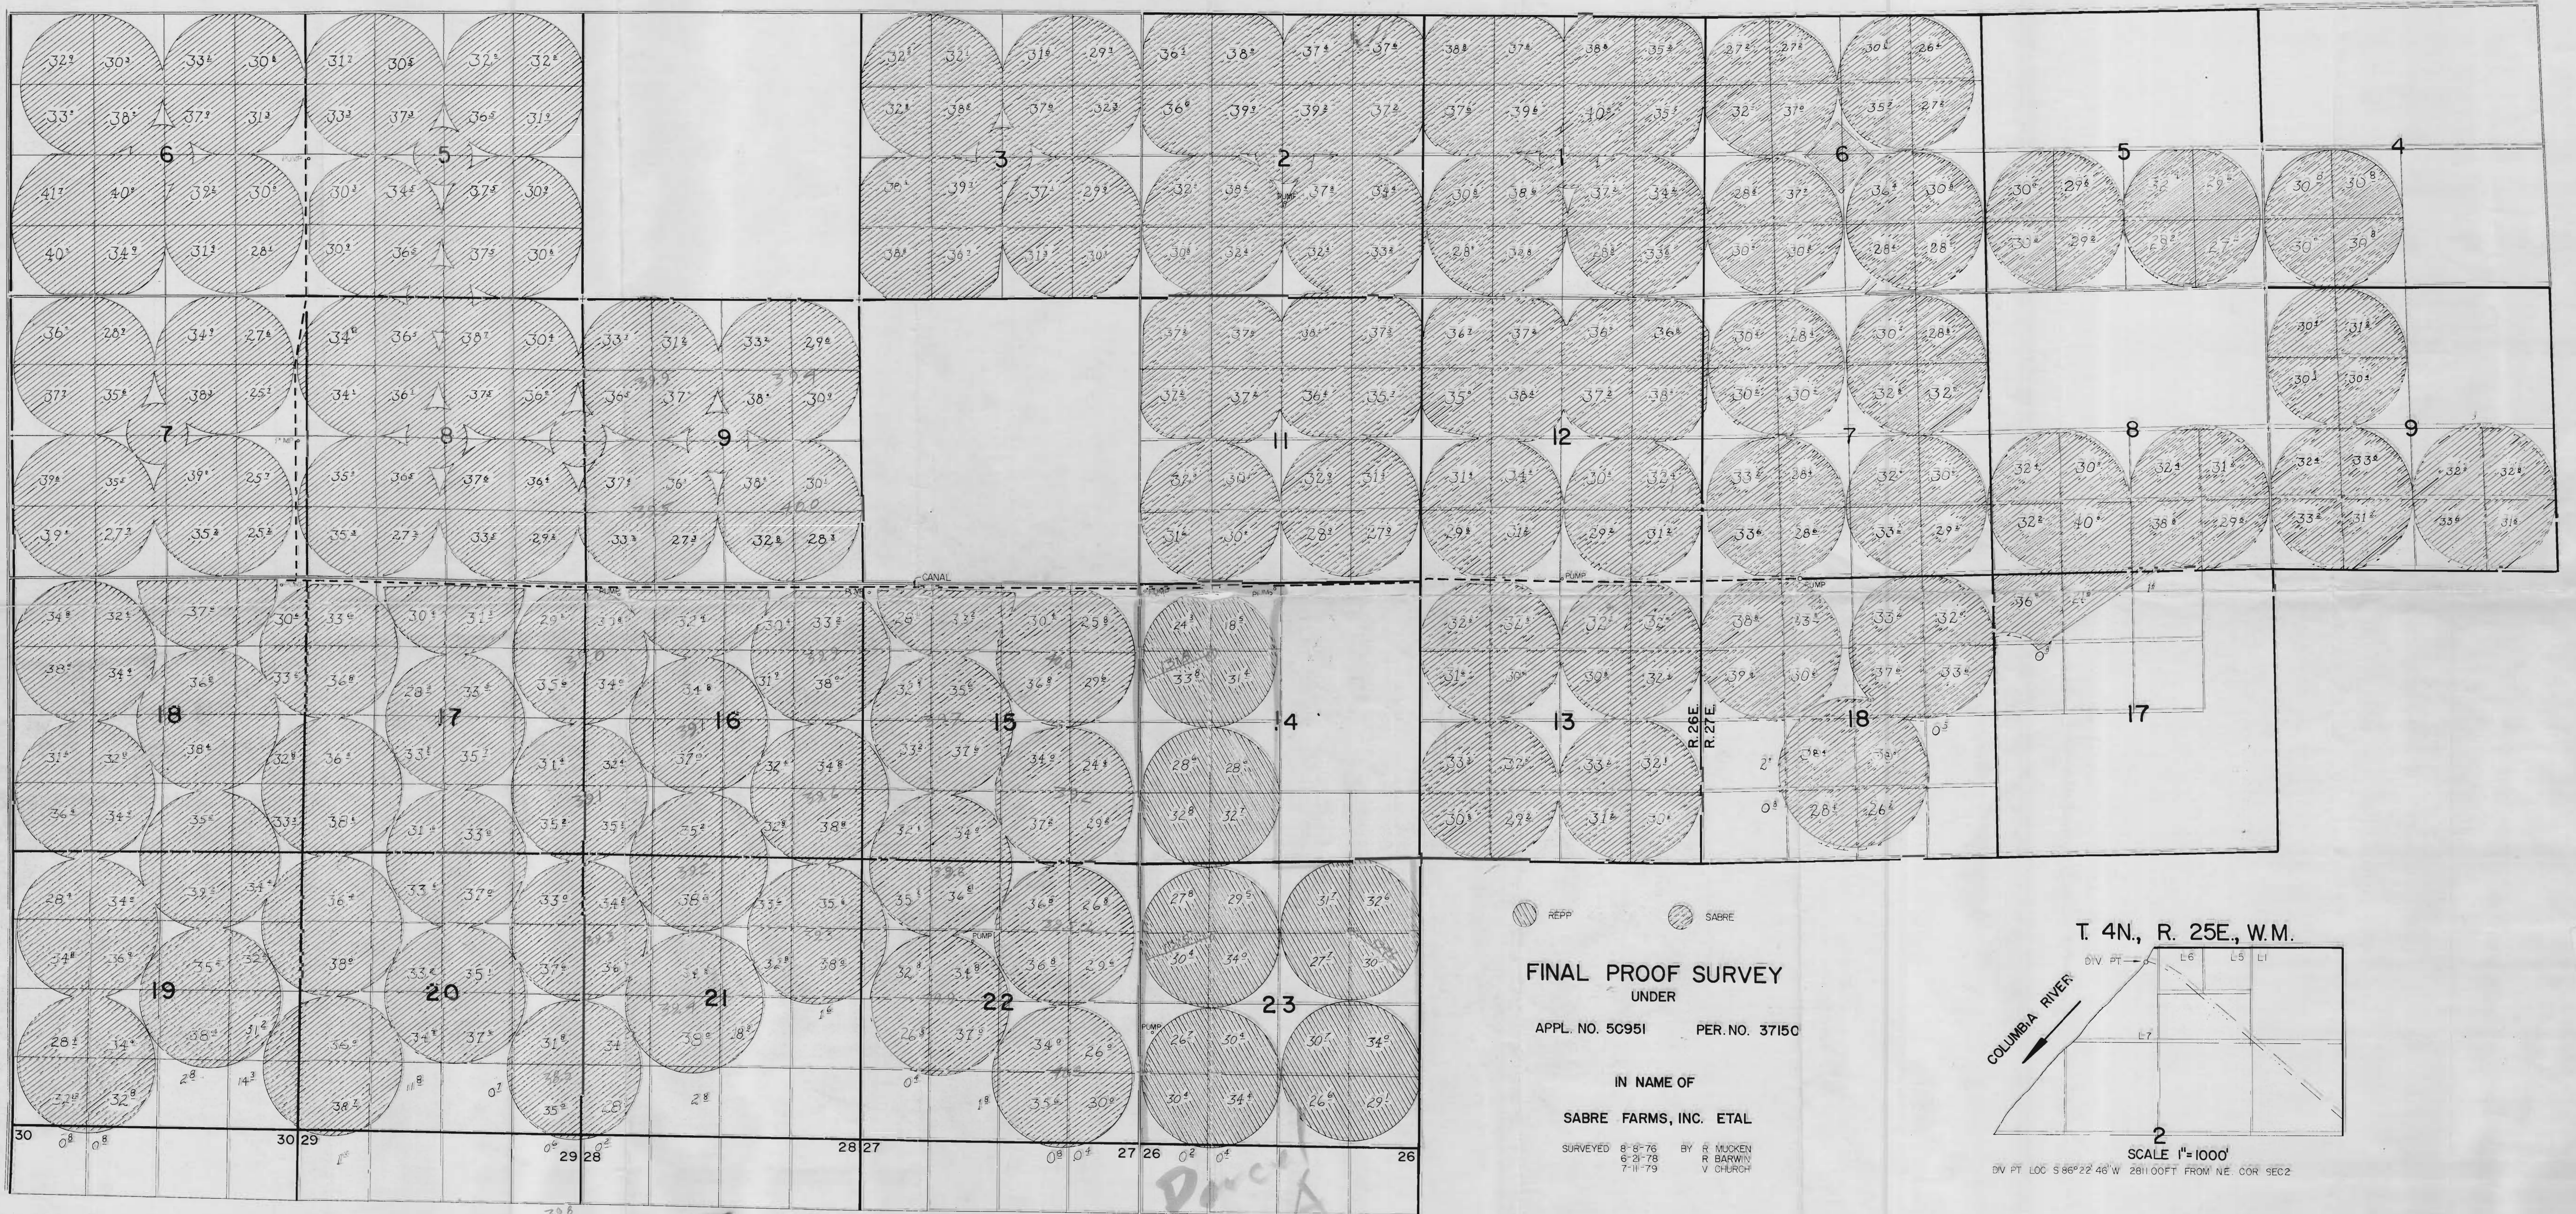

REPP SABRE

FINAL PROOF SURVEY
UNDER


APPL. NO. 5C951 PER. NO. 37150

IN NAME OF

SABRE FARMS, INC. ETAL

SURVEYED 8-8-76 BY R. MUCKEN
6-21-78 R. BARWIN
7-11-79 V. CHURCH

T. 4N., R. 25E., W.M.

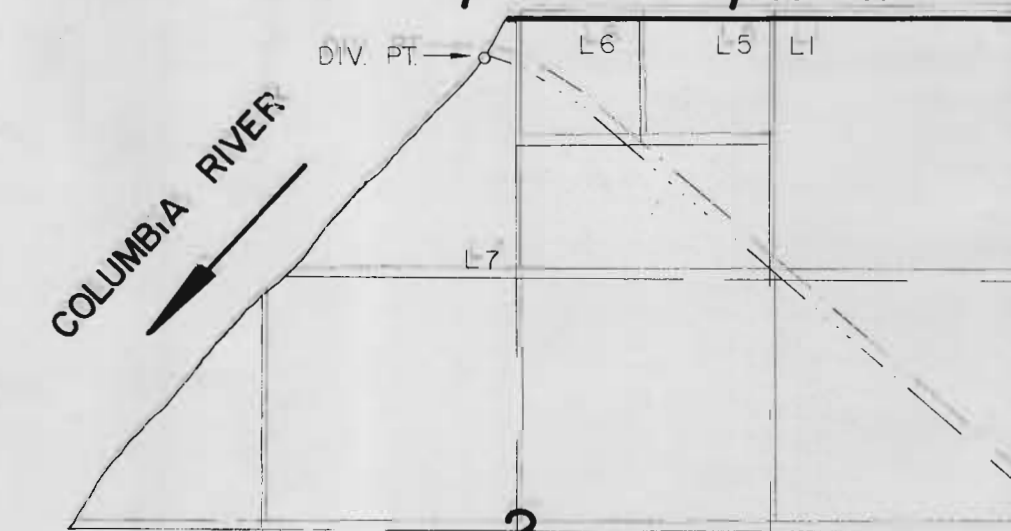

SCALE 1"=1000'

DIV. PT. LOC. S 86° 22' 46" W 2811.00 FT FROM N.E. COR. SEC. 2