

R. 26E. WM.
 R. 26E. WM.
 R. 26E. WM.

NOT TO SCALE

*So large
map file*


T2N R26E W.M.

SABRE PHOTO 1-7 11:10
 PFS-1979-P.A

V.L.C.

T. 2N. R. 26E. W. M.

75848
52085
L4190
72774

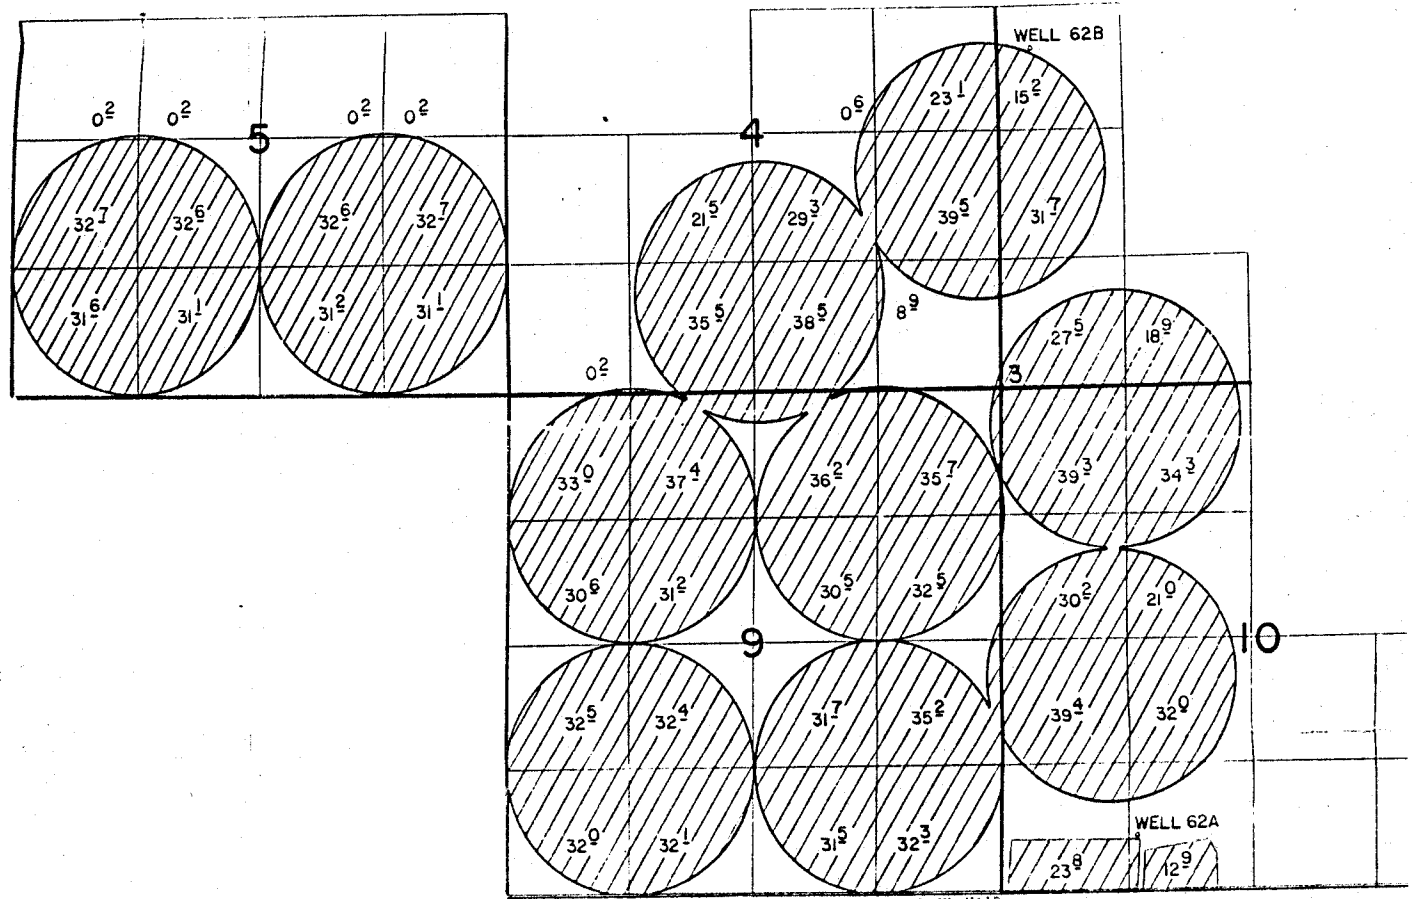

WELL 62B LOCATED 350'N & 350'E FROM SW COR SEC 3 T. 2N., R. 26E. W.M.
 WELL 62A LOCATED 560'N & 1450'E FROM SW COR SEC 10 T. 2N., R. 26E. W.M.
 WELL 62 LOCATED 3700'S & 1790'E FROM NW COR SEC 23 T. 2N., R. 26E. W.M.

FINAL PROOF SURVEY
 UNDER

APPL. NO. G-5096 PER. NO. G-4918

IN NAME OF
CONNECTICUT GEN. LIFE INS. CO.
 SURVEYED MAY 3, 1979 by R. BARWIN

NOT TO SCALE
As large as possible