


T. 1S., R. 38E., W. M.

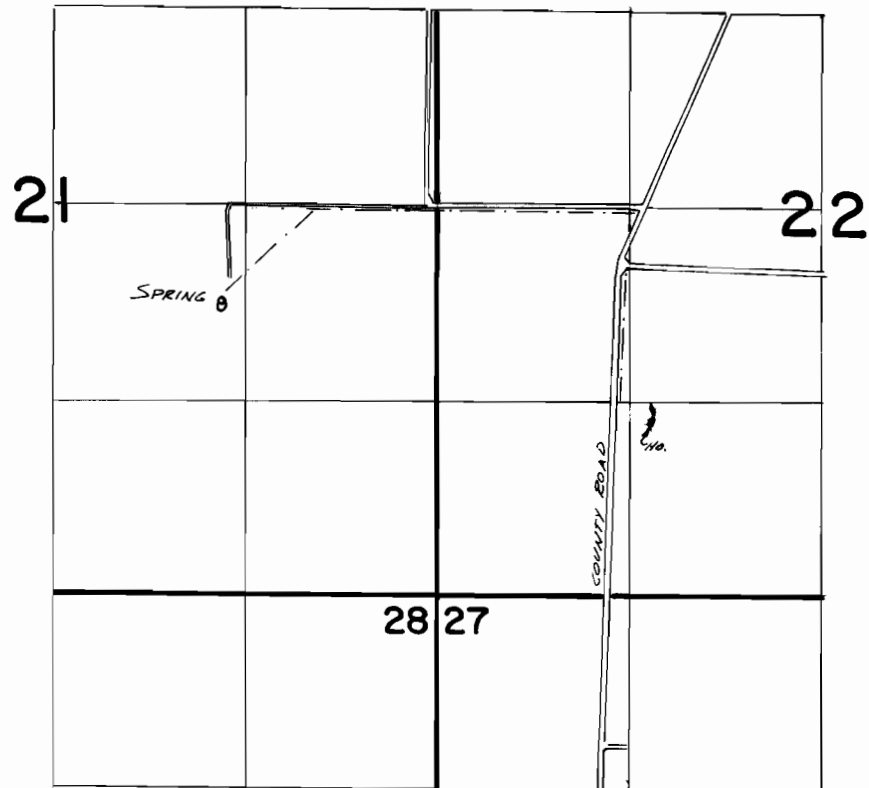

SPRING LOC: 640'S & 1490'W. FROM W 1/4 COR SEC 22

**FINAL PROOF SURVEY**  
UNDER

Application No. **58386** Permit No. **44045**  
IN NAME OF

**B.L. DAVIS RANCH, INC.**

Surveyed *Dec 19* 1981, by *R. Church*