


T.2N.,R.14E.,W.M.

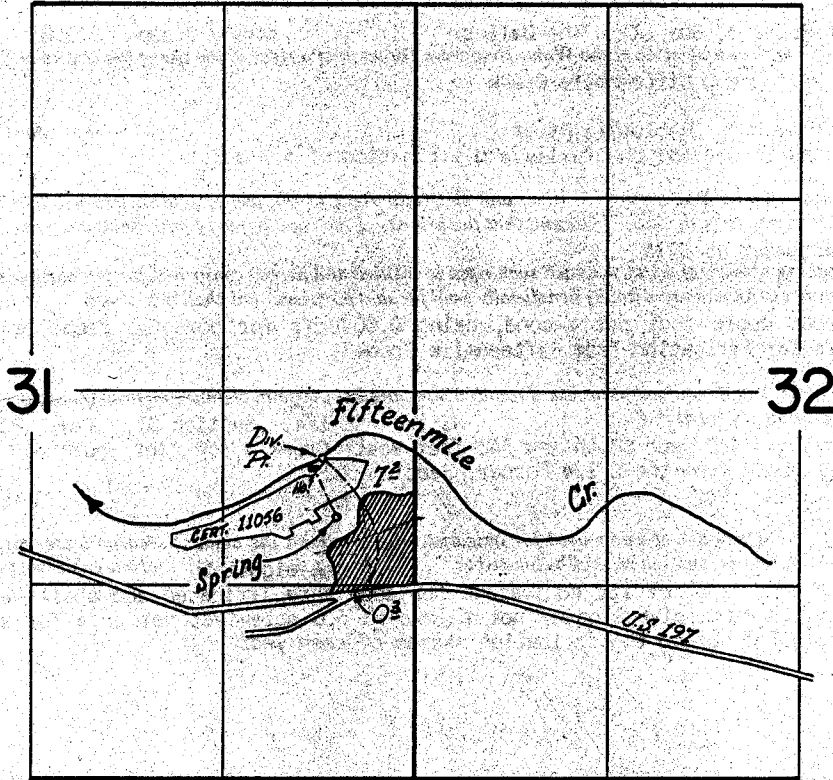

*DIV. Pts. Loc.: SPRING-860' S + 540' W; CREEK-450' S + 640' W; DORN FROM S. 1/4 cor. Sec. 31.*

**FINAL PROOF SURVEY**  
UNDER

Application No. 53611... Permit No. 40325.  
IN NAME OF

JACK A. WATERS

Surveyed June 29 1977, by R.G. Muckers...