


T. 18 & 2 N., R. 14 E., W.M.

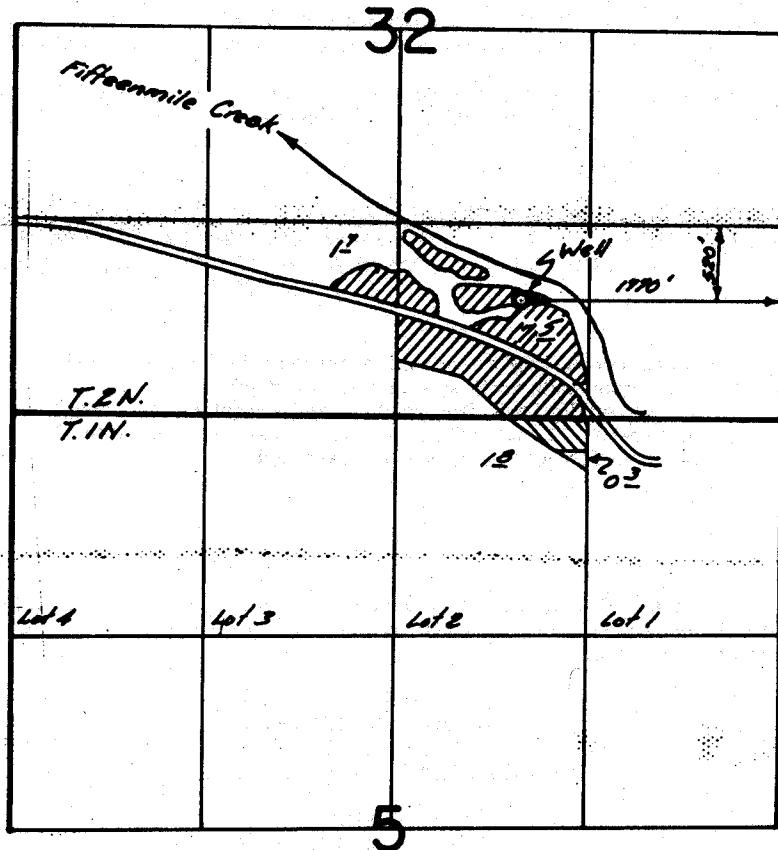

Primary



Supplemental



FINAL PROOF SURVEY
UNDER

Application No. G-8314 Permit No. G-7677

IN NAME OF

Richard E. Tenold

Surveyed July 26 1979, by D. H. [unclear]