


T.2N.,R.4W.,W.M.

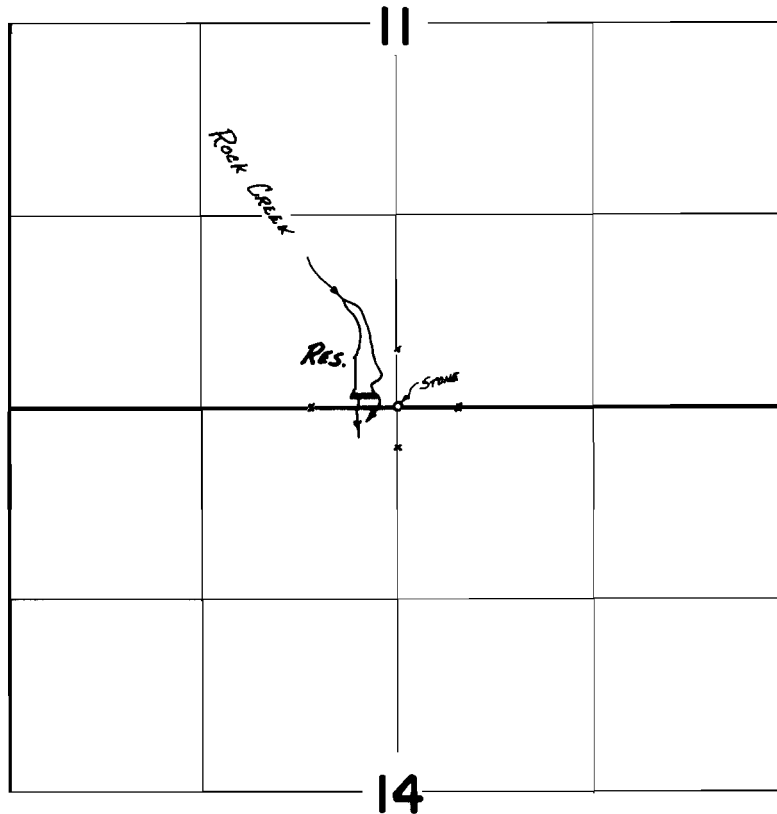

Div. Pt. Loc.: 50' N. & 250' W. from S. 1/4 cor. Sec. 11

FINAL PROOF SURVEY
UNDER

R-47135 R-5556
Application No. 47136 Permit No. 34796
IN NAME OF

JOHN F. WOOD

Surveyed JUNE 28 1973, by D. NORBY