


T.1S. R.2W. W.M.

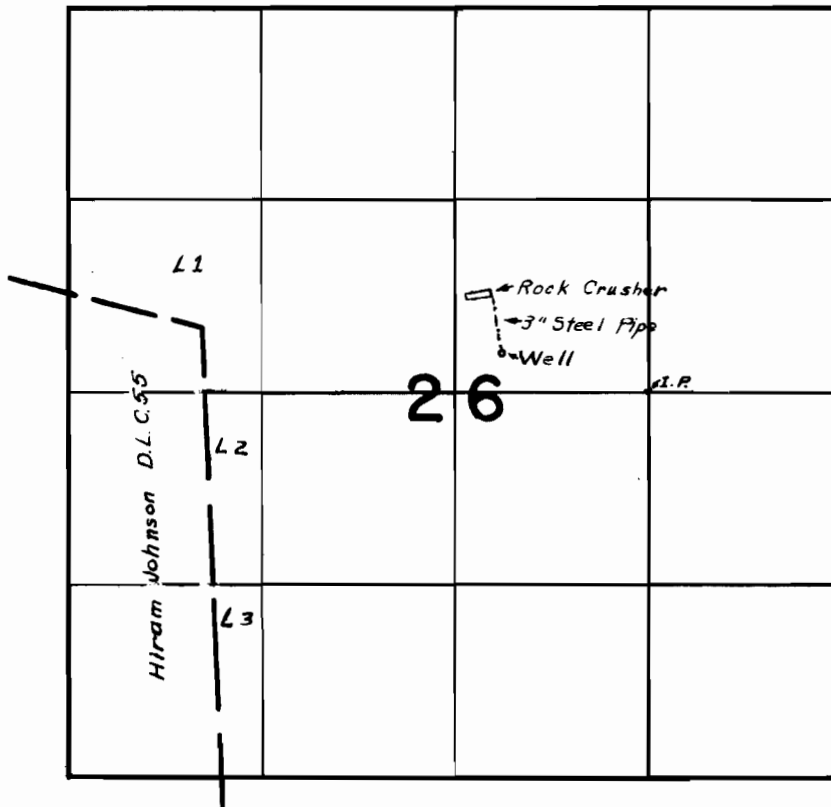

FINAL PROOF SURVEY UNDER

Application No. G-2157 Permit No. G-1985
IN NAME OF

BAKER ROCK CRUSHING CO., INC.

Surveyed May 25, 1964, by M. Bish