


T.9S.R.25E.W.M.

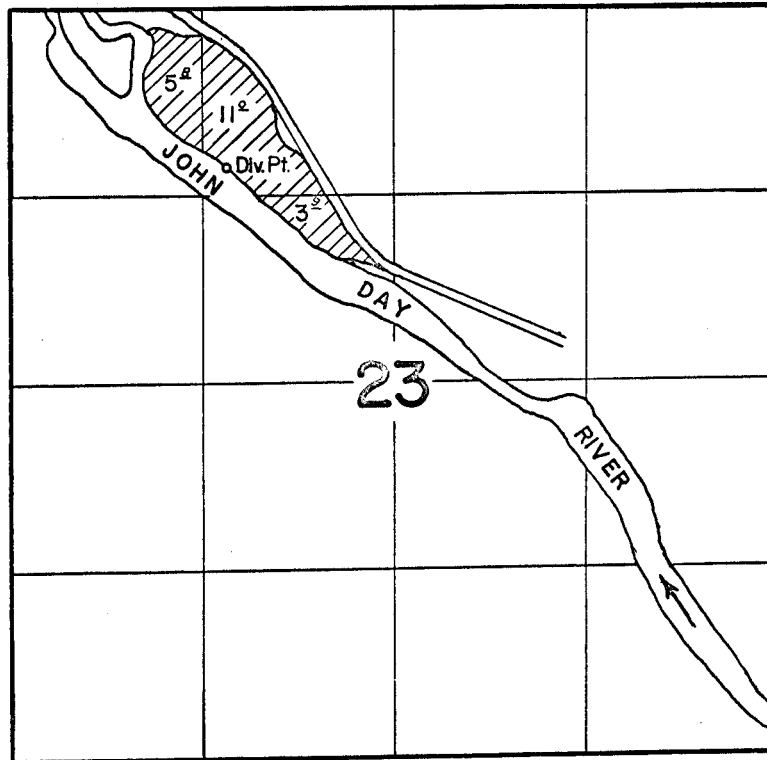

FINAL PROOF SURVEY
UNDER

Application No. 30513 Permit No. 24024
IN NAME OF

E. Earl McCarty

Surveyed Oct. 11 & 12 1961, by C.O. Bartels