T-165

T.8&9S.R.25E.W.M.

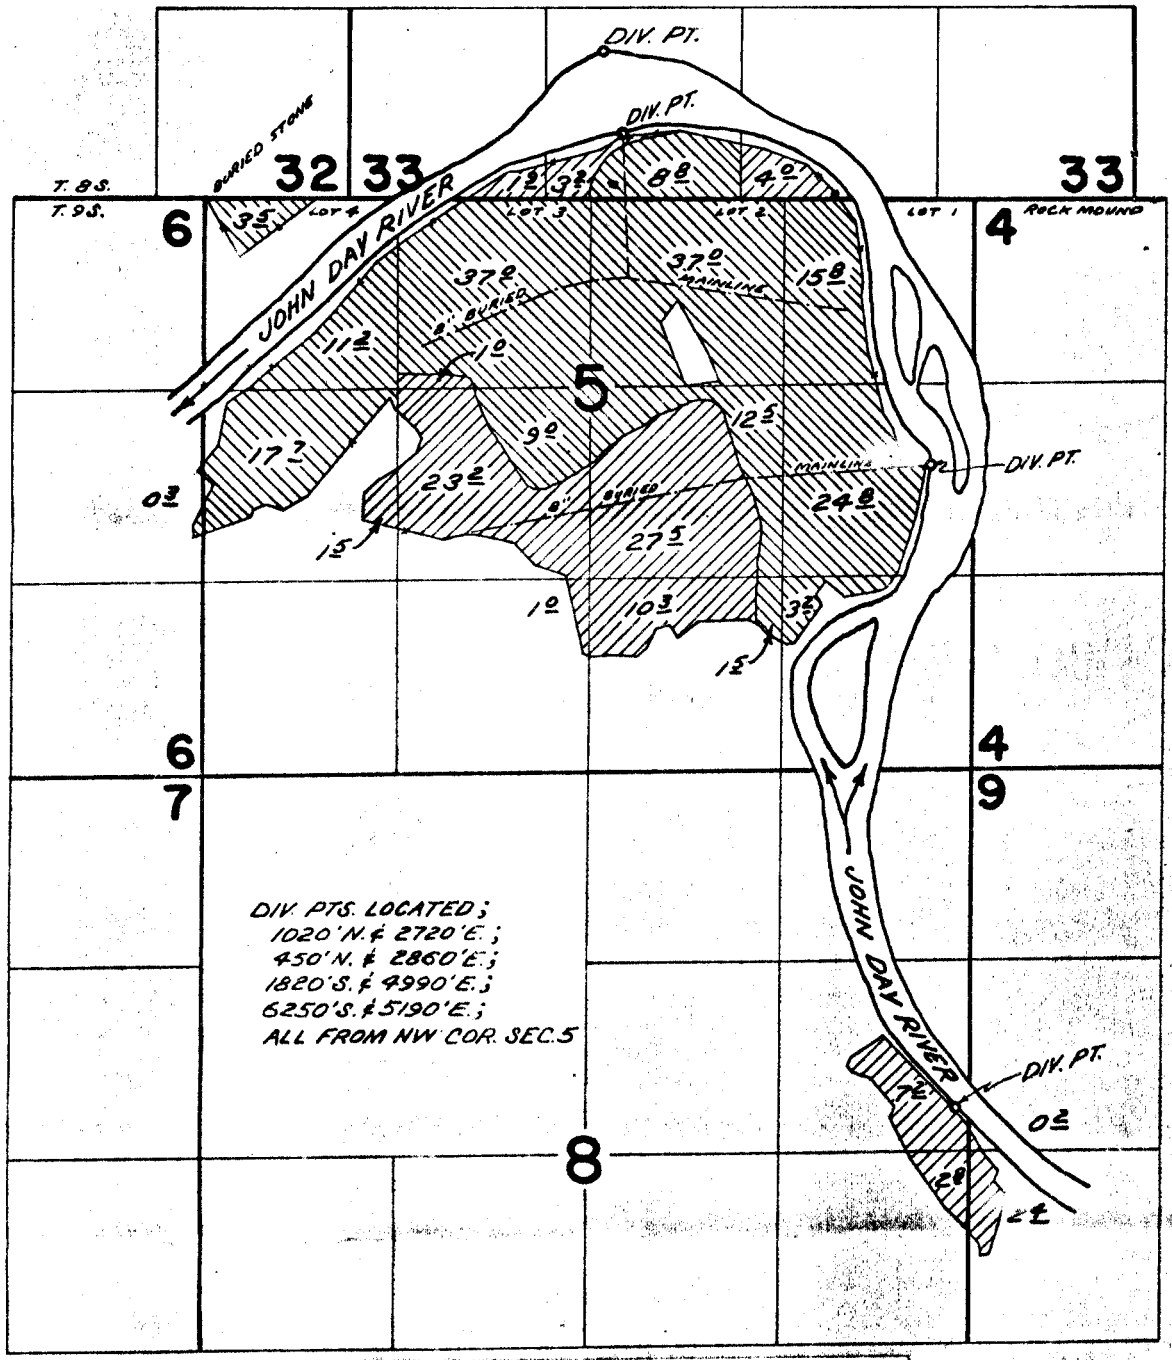

Proof of appropriation signed, but to date (Sept 1, 1978) certificate has not been issued.

TRANSFER No. M-165

Application No. 44149 Permit No. 32864

IN NAME OF

ANDREW F. & MAXINE F. LECKIE

Surveyed FEB 9-11 1970, by D. BUELL

1970-A