


# T. 4 S., R. 4 W., W.M.

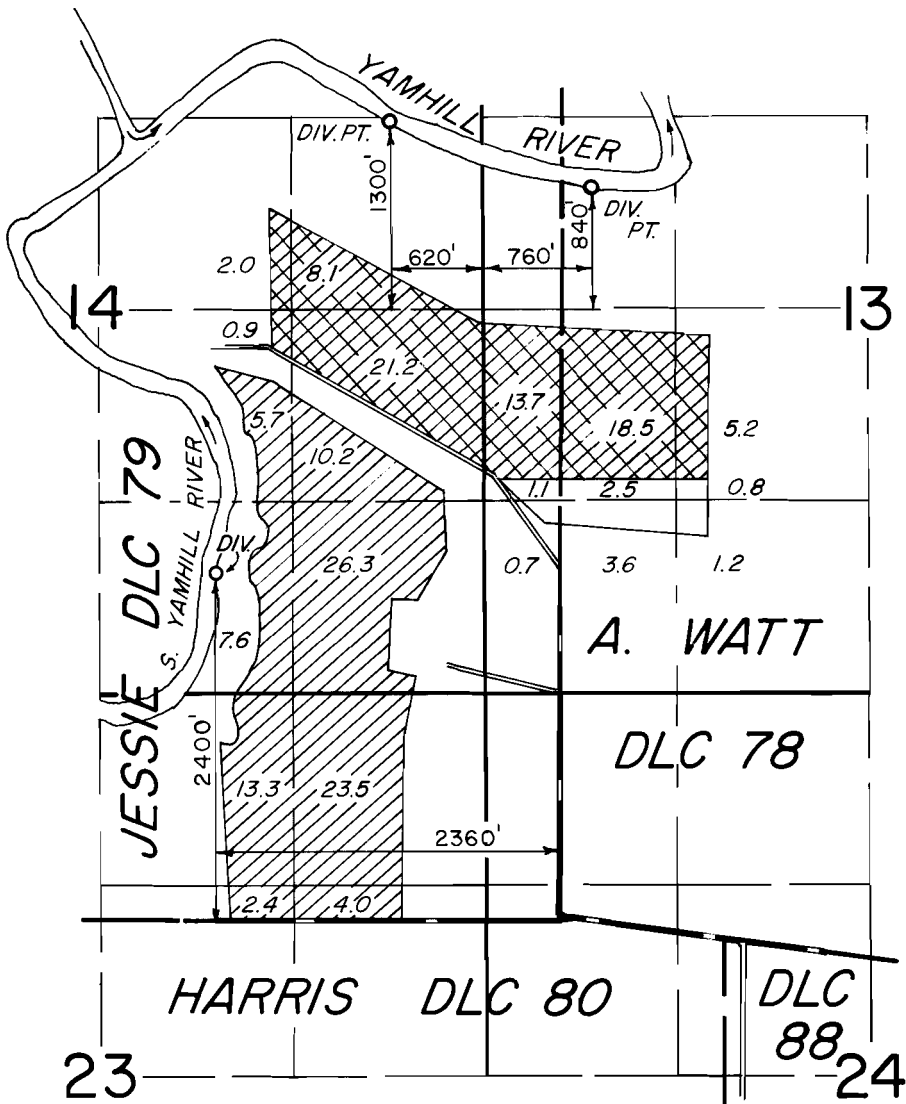

## FINAL PROOF SURVEY UNDER

Application No. 50060... Permit No. 37625...  
 Application No. 50061... Permit No. 37626...

IN NAME OF

**NORMAN REID**

Surveyed MAY 8, 1979, by [Signature]

