


T.4S., R.3W., W.M.

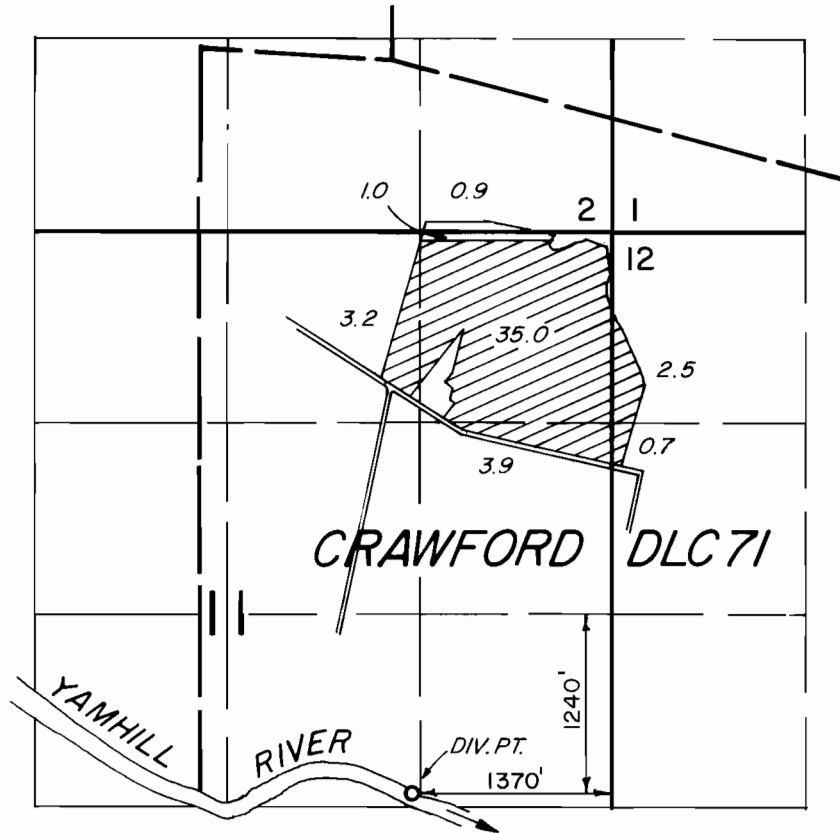

**FINAL PROOF SURVEY**  
UNDER

Application No. 52923 Permit No. 39960

IN NAME OF

**JACK SHELBURNE**

Surveyed MAY 9, 1979, by C. RODRIGUEZ.