

UNITED STATES
DEPARTMENT OF THE INTERIOR
BUREAU OF LAND MANAGEMENT


SECTION

*20

Oregon State Water Filings

TOWNSHIP 23S, RANGE 40E, W. M.

North

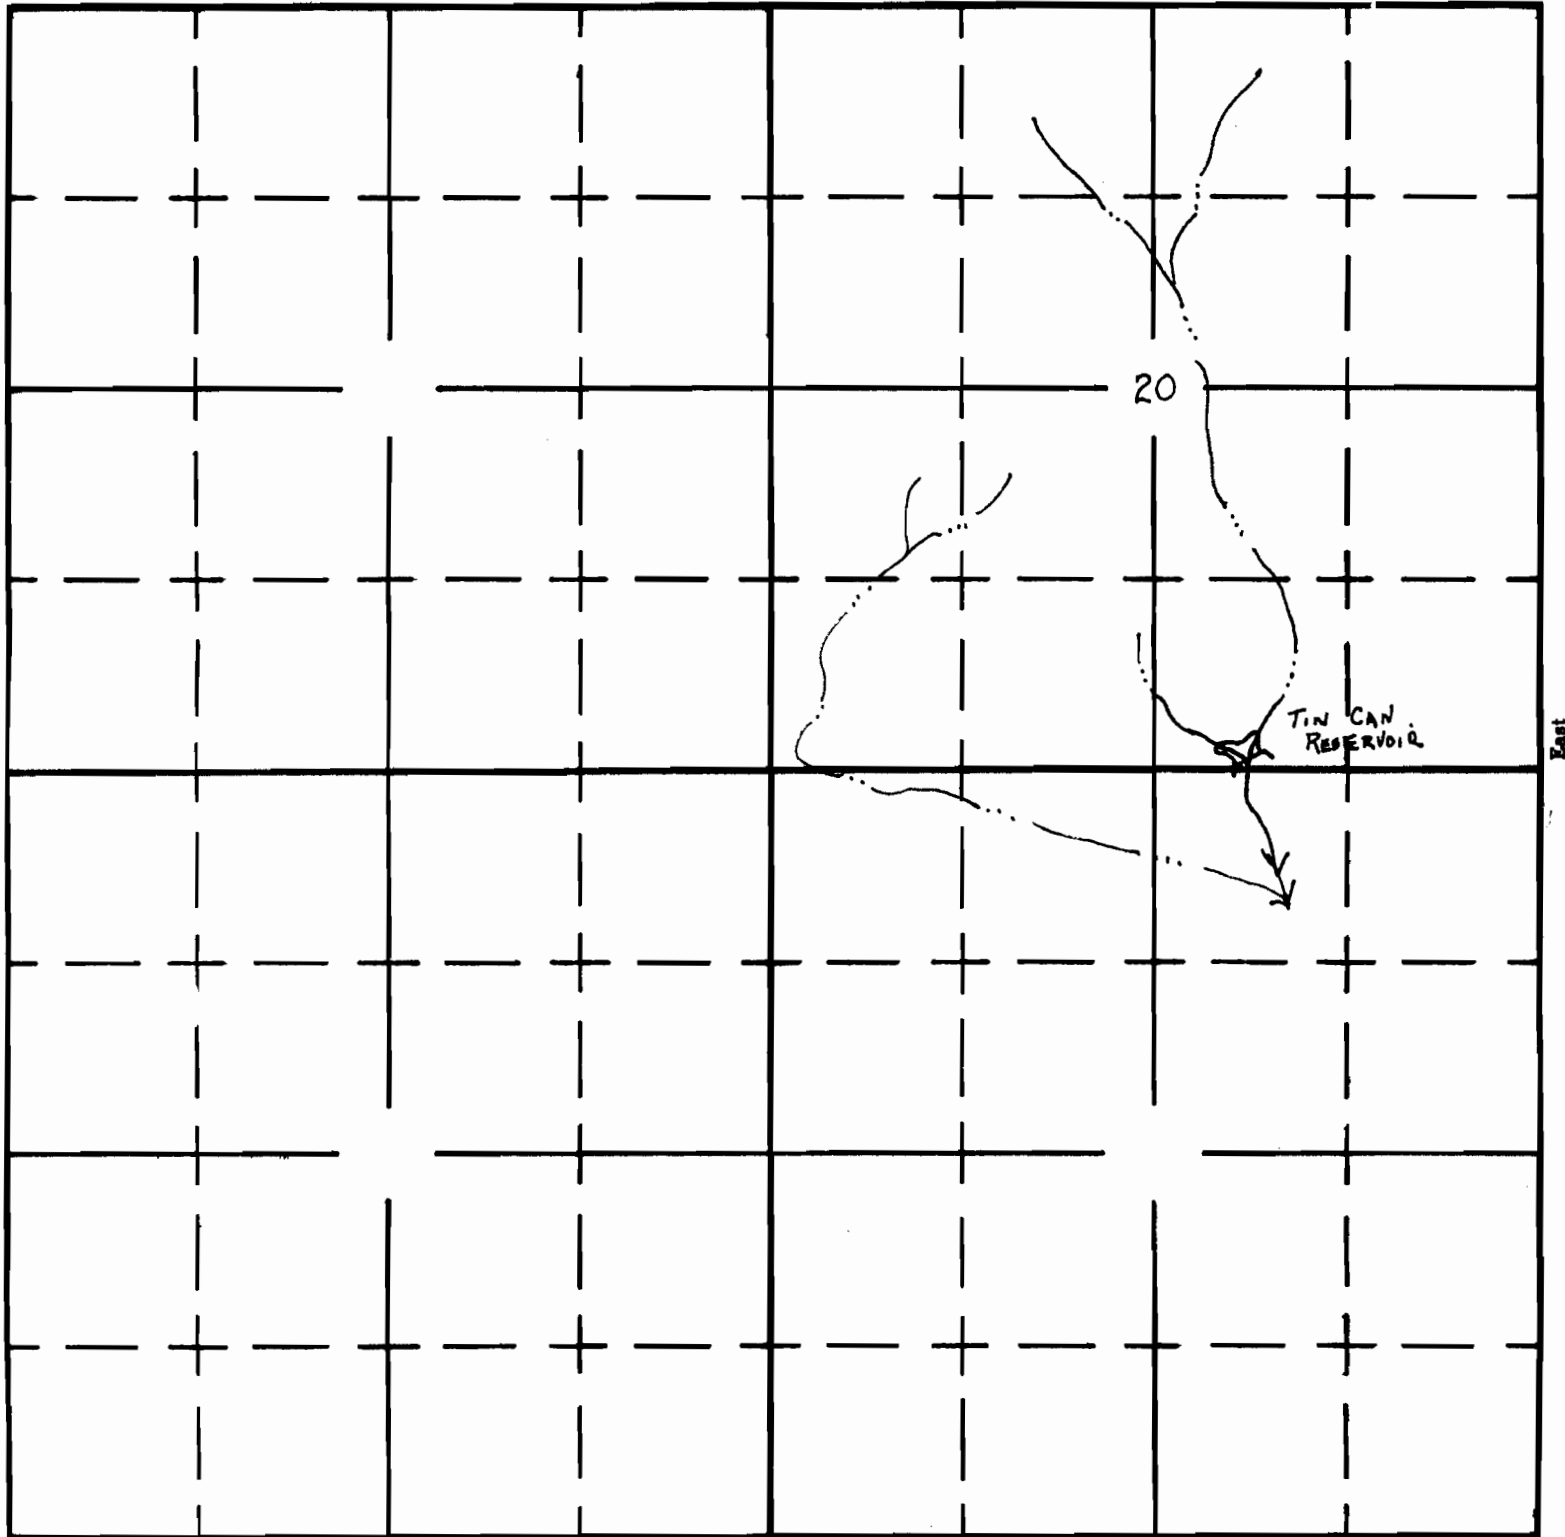

South

APPLICATION No. R-33901

PERMIT No. R-2632