


UNITED STATES
DEPARTMENT OF THE INTERIOR
BUREAU OF LAND MANAGEMENT

SECTION

* 12

Oregon State Water Filings

TOWNSHIP 23S, RANGE 37E., W. M.

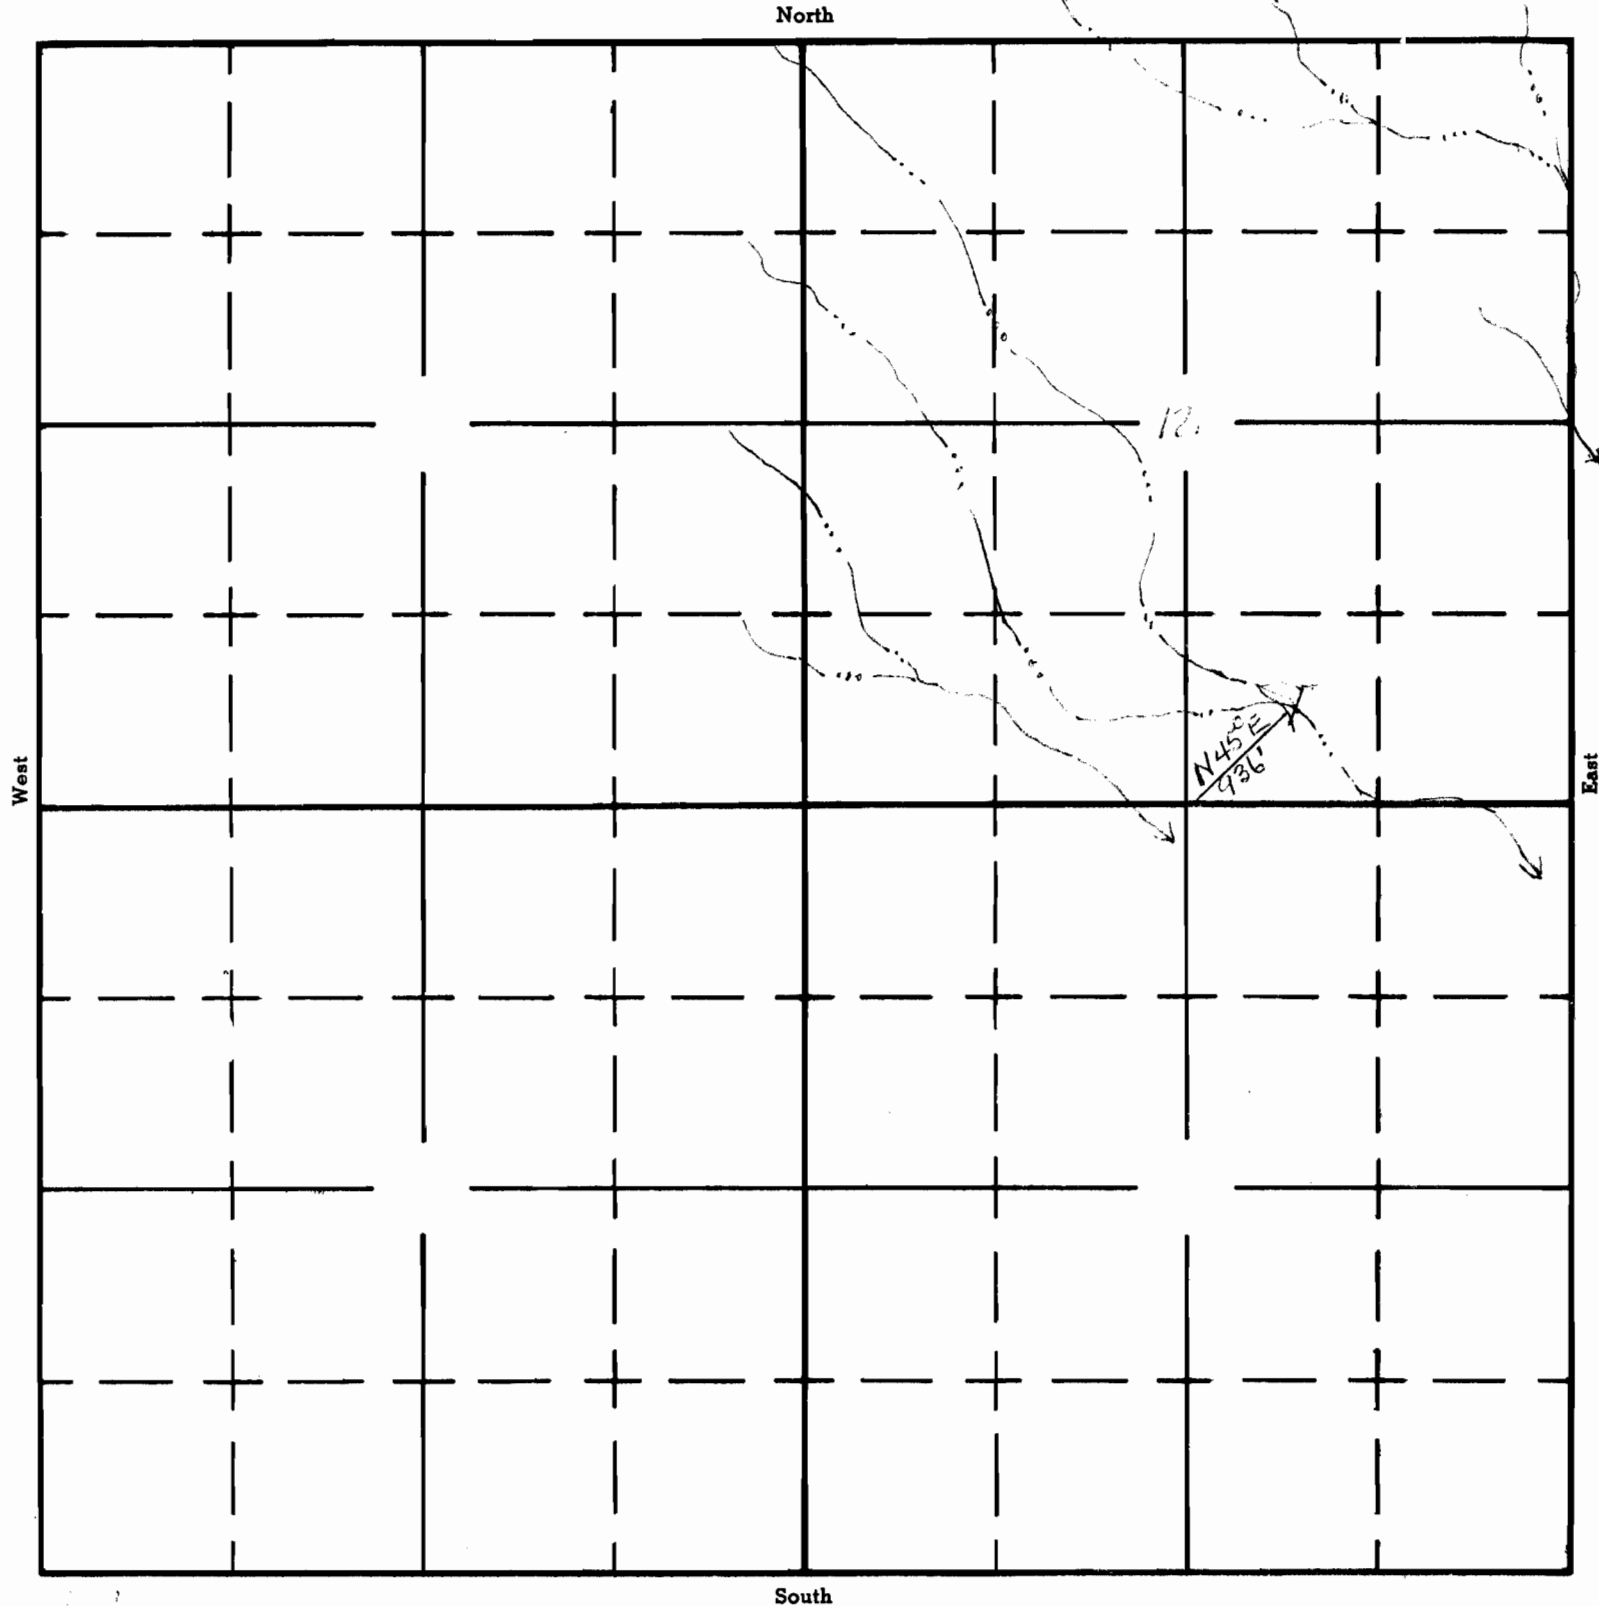

APPLICATION No. R-34381
PERMIT No. R-2547