

Form AI-187
March 1961

UNITED STATES
DEPARTMENT OF THE INTERIOR
BUREAU OF LAND MANAGEMENT


SECTION

#35

Oregon State Water Filings

TOWNSHIP 32S, RANGE 44E, W. M.

North

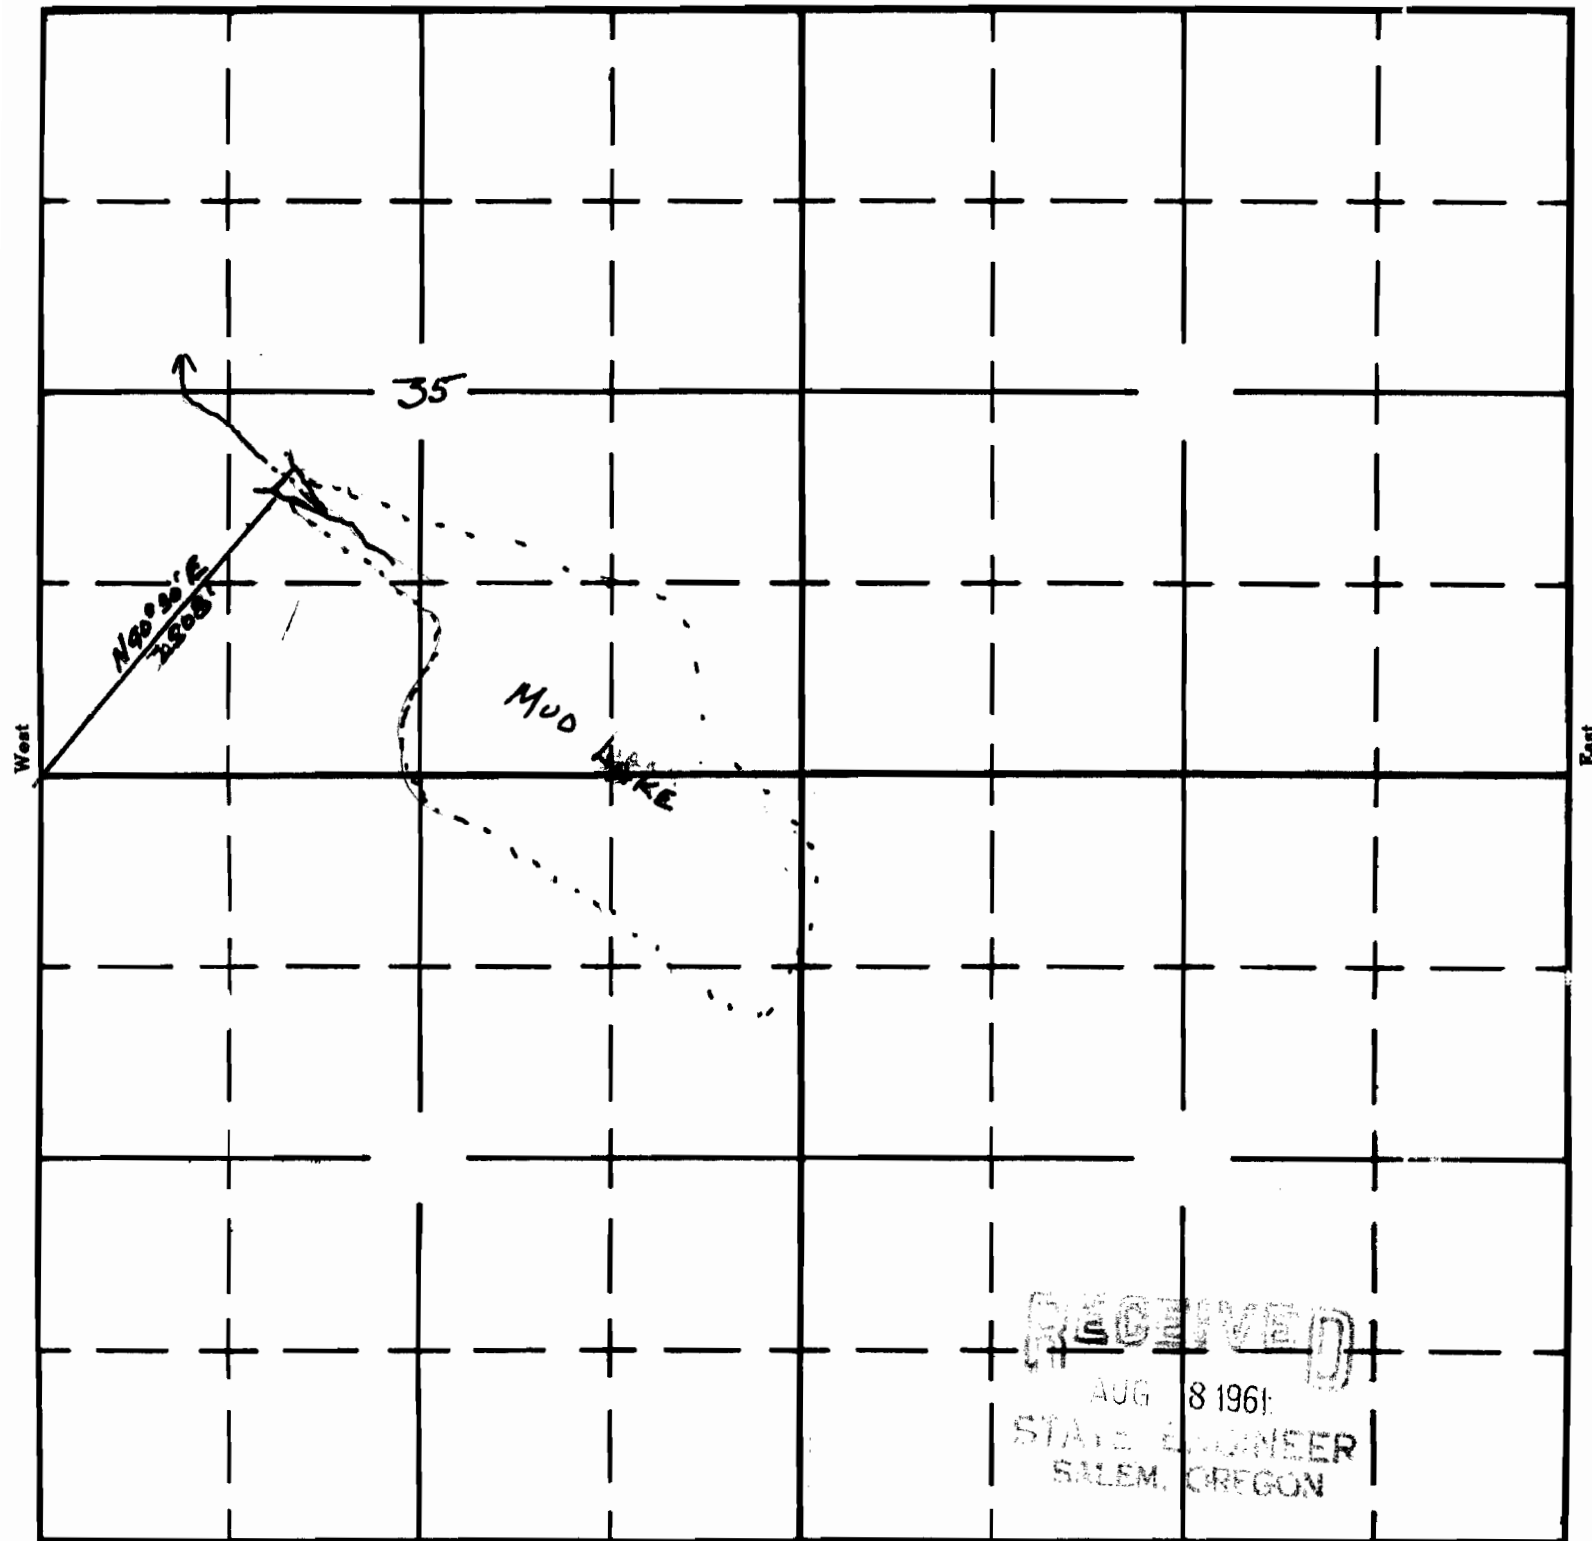

APPLICATION No. R-36634

PERMIT No. R-3790