

UNITED STATES
DEPARTMENT OF THE INTERIOR
BUREAU OF LAND MANAGEMENT


SECTION 26

Oregon State Water Filings

TOWNSHIP 22S, RANGE 45E, W. M.

Stark Res.

North

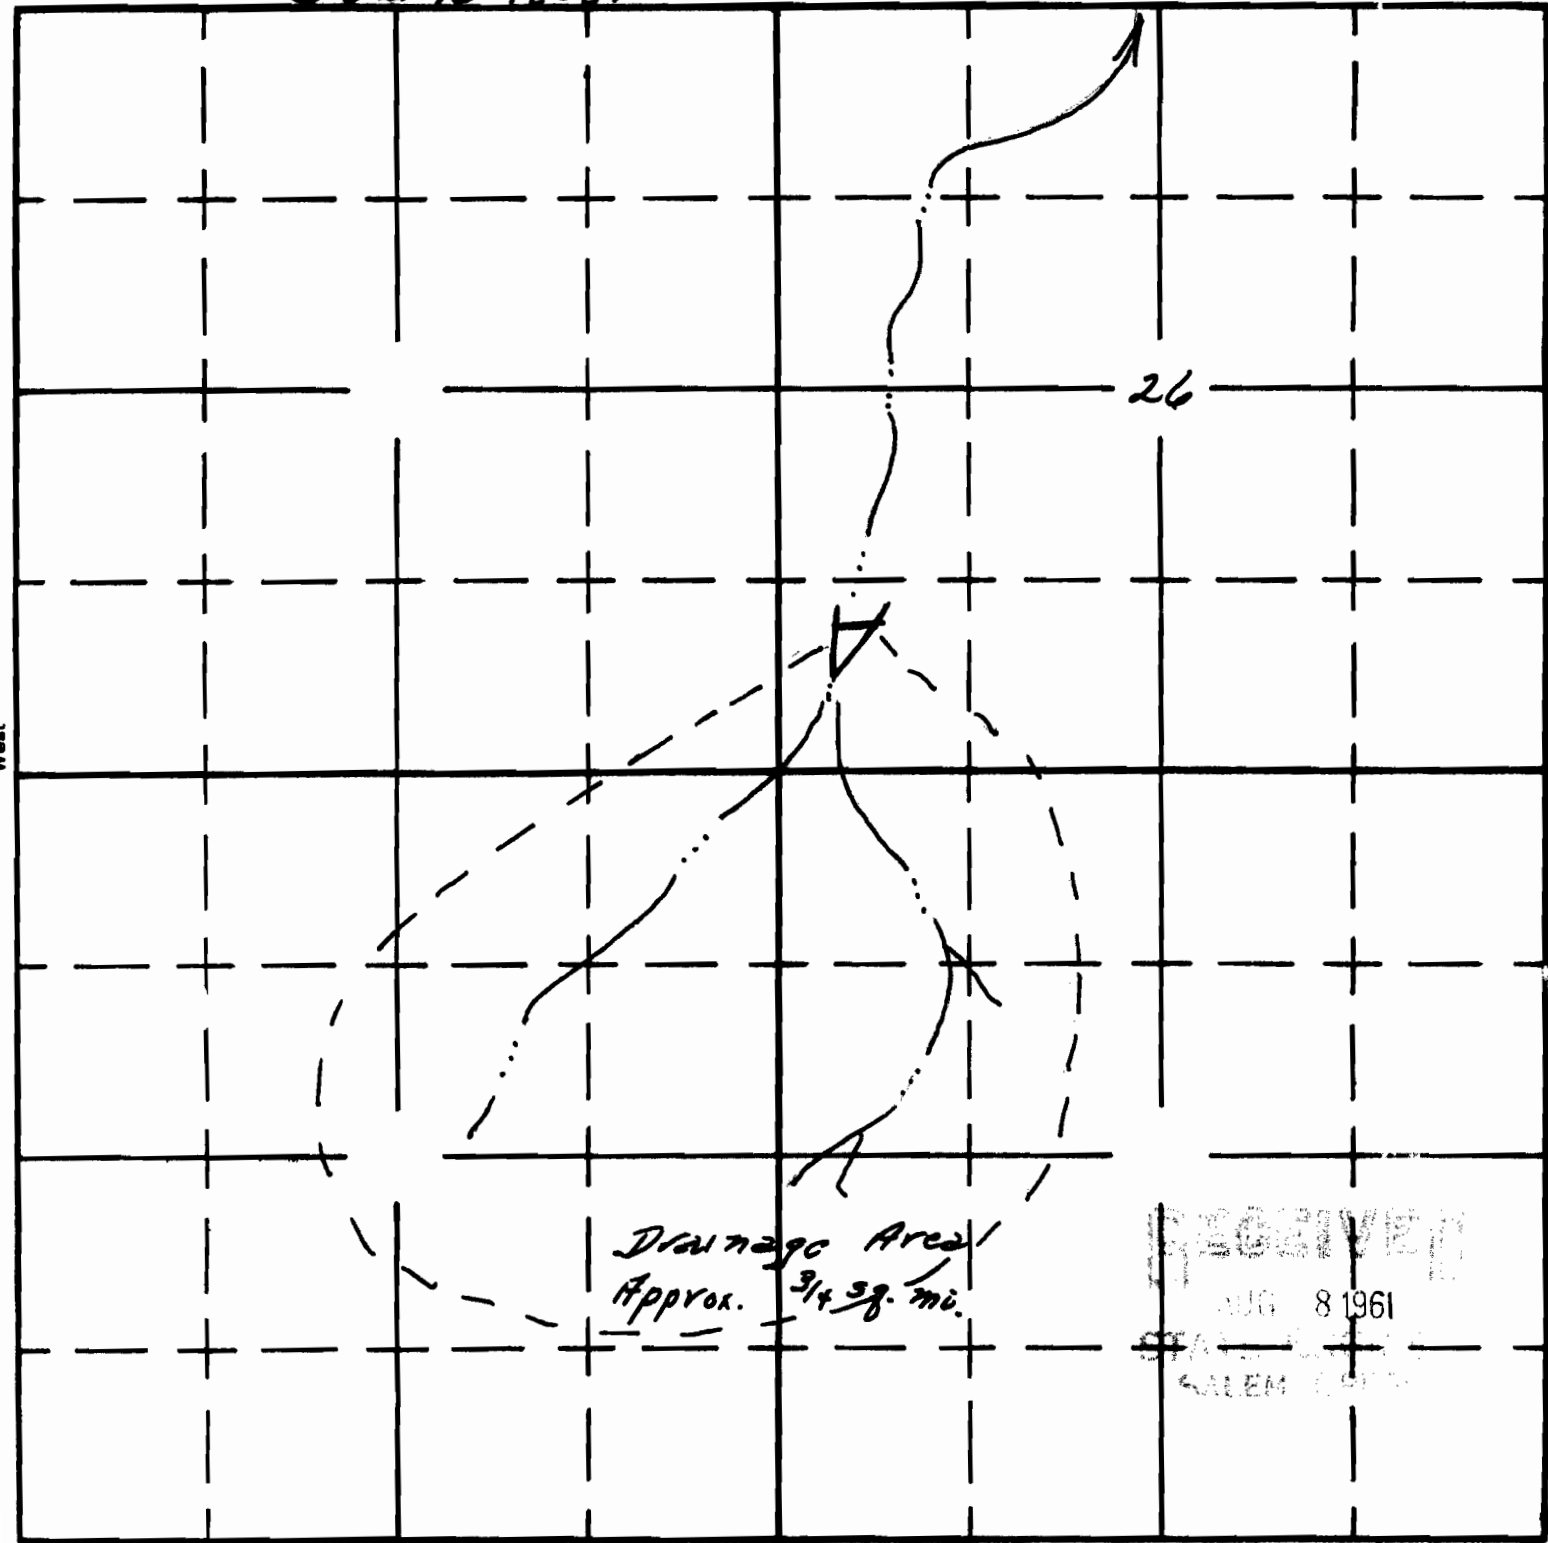

*Drainage Area

RECEIVED
AUG 8 1961
STATE OF OREGON
SALEM, OREGON

South

APPLICATION No. **R-36655**

PERMIT No. **R-4265**