


UNITED STATES
DEPARTMENT OF THE INTERIOR
BUREAU OF LAND MANAGEMENT

SECTION

Oregon State Water Filings

5 TOWNSHIP 32S, RANGE 37E, W. M.

West Post Res. North

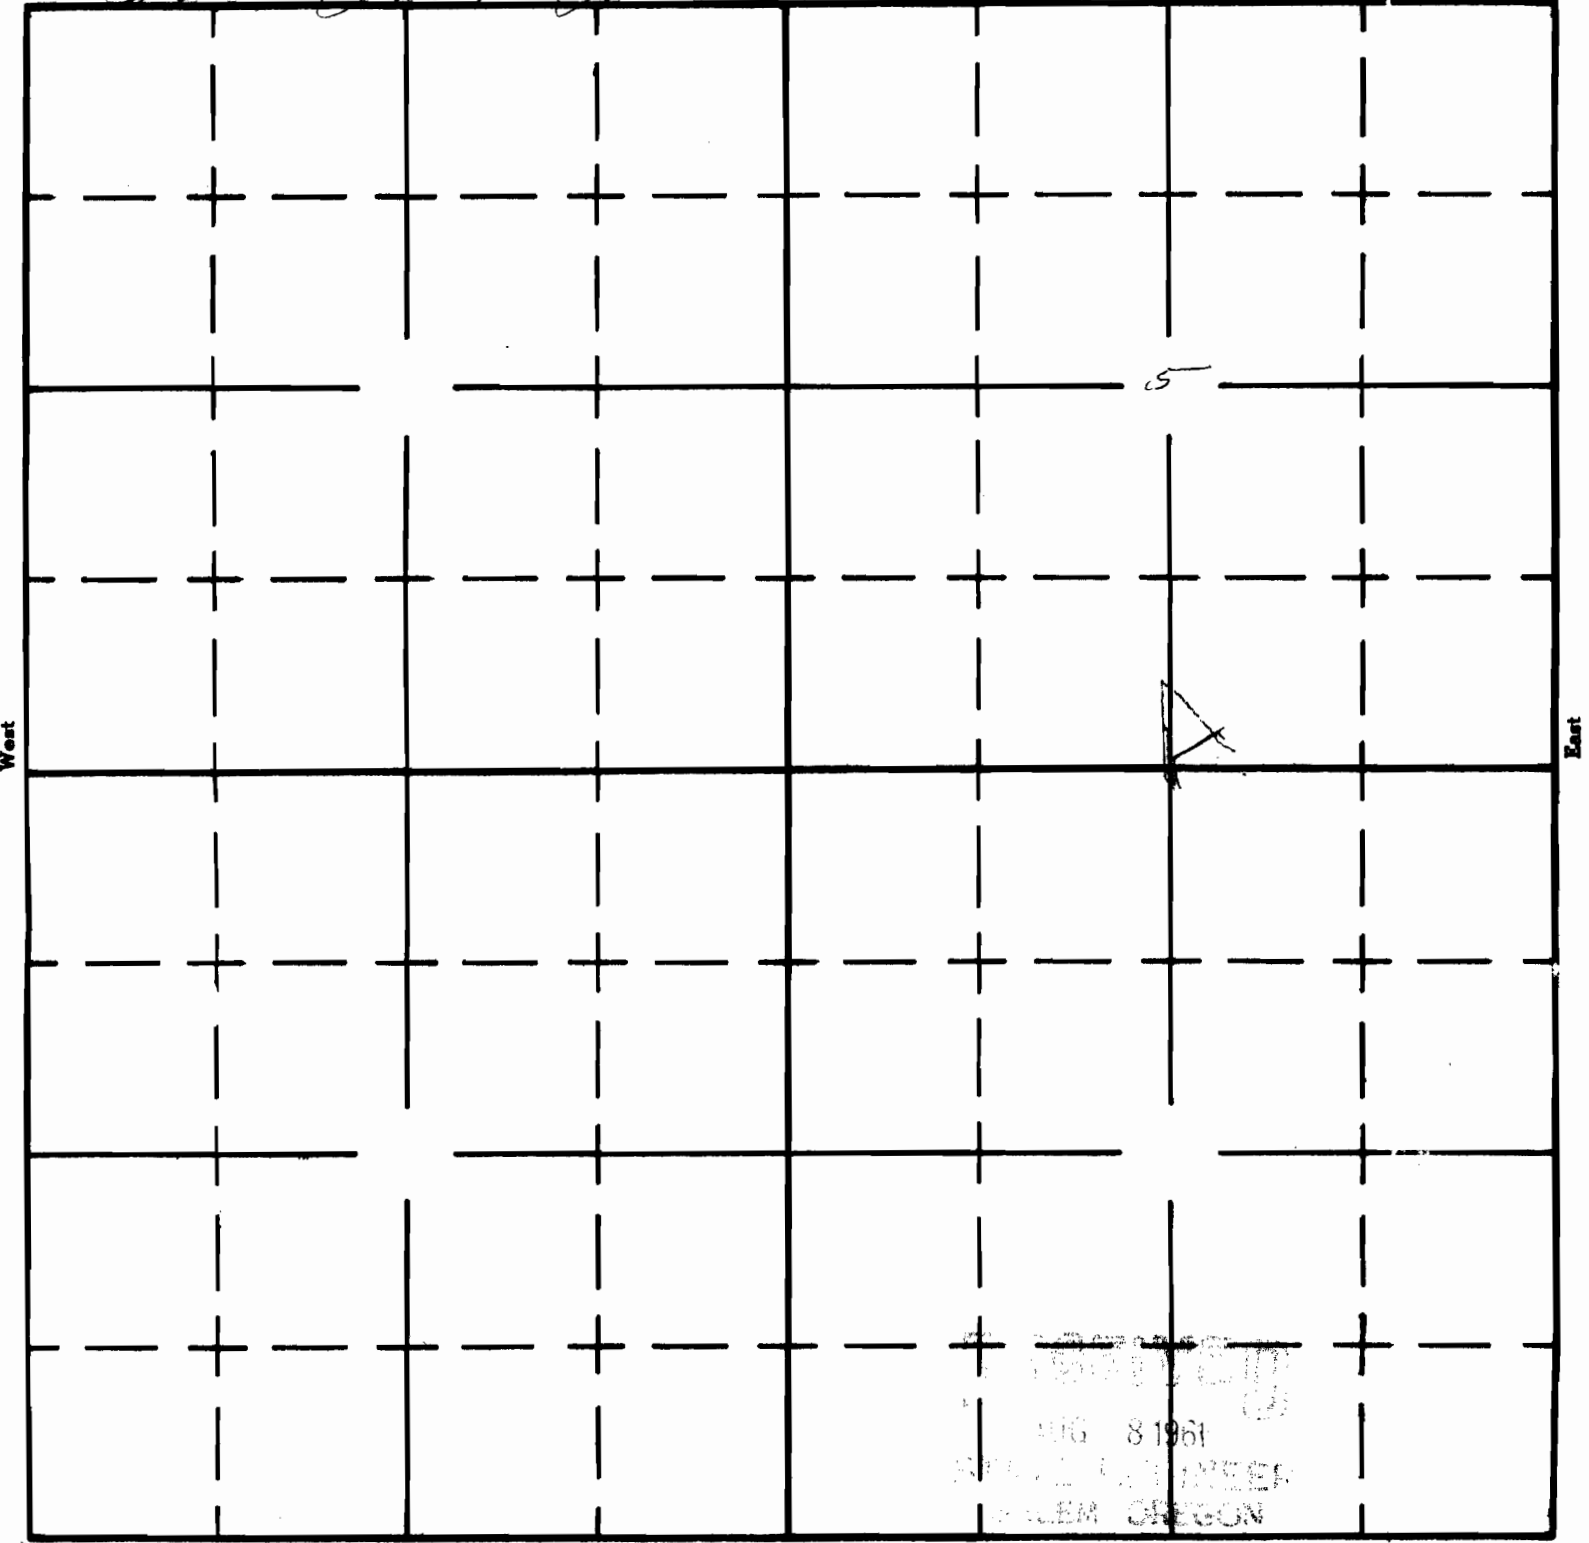

South

APPLICATION No. R-36707
PERMIT No. R-3927