


Form AI-187
March 1961

UNITED STATES
DEPARTMENT OF THE INTERIOR
BUREAU OF LAND MANAGEMENT

SECTION

Oregon State Water Filings

TOWNSHIP 23S, RANGE 35E, W. M.

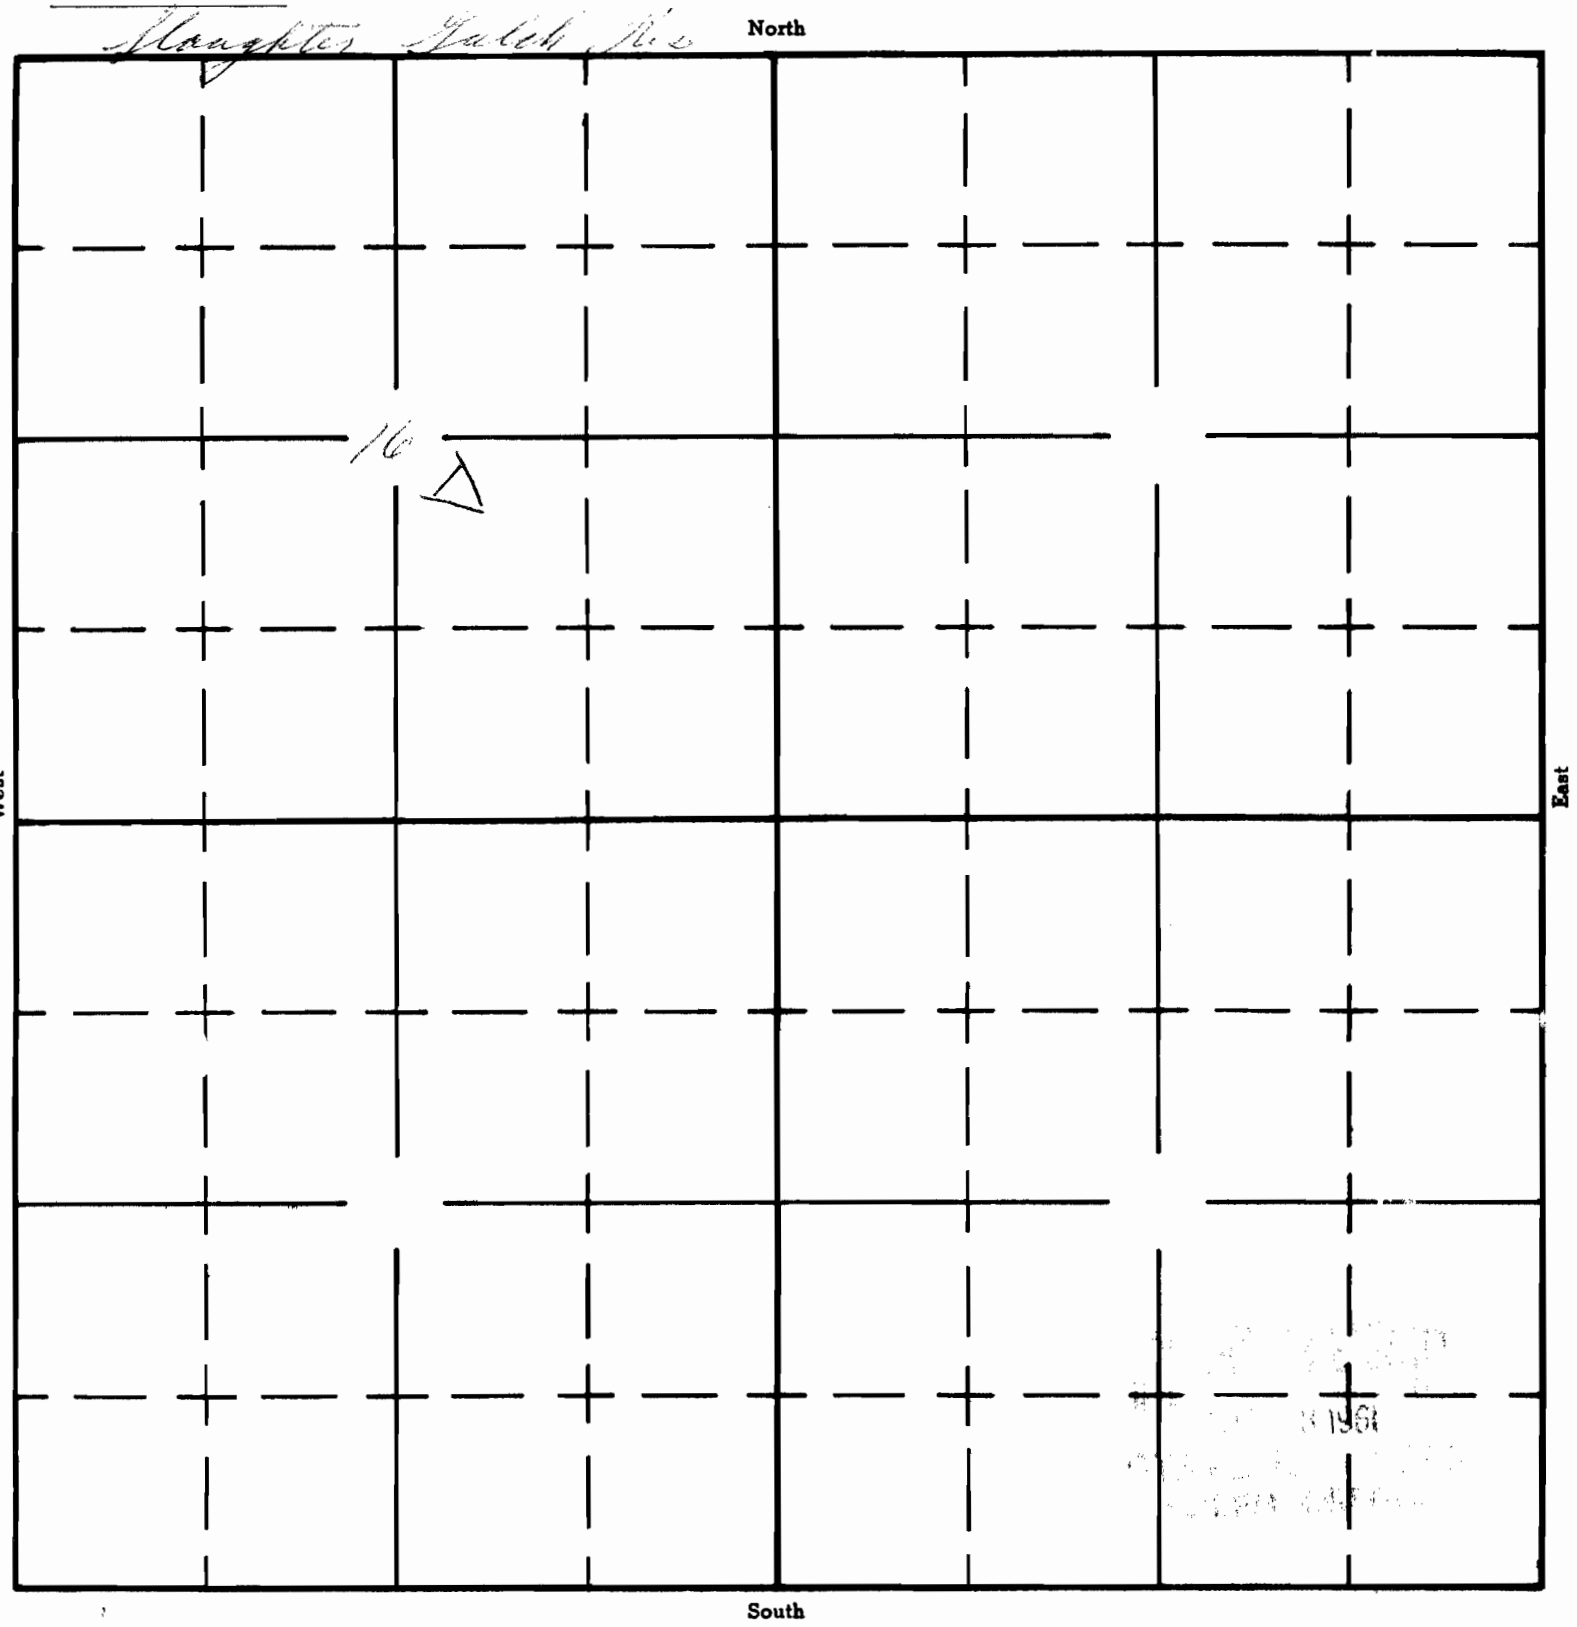

APPLICATION No. R-36816
PERMIT No. R-3377