

Form AI-187
March 1961


UNITED STATES
DEPARTMENT OF THE INTERIOR
BUREAU OF LAND MANAGEMENT

SECTION

Oregon State Water Filings

TOWNSHIP 23 S, RANGE 40 E, W. M.

North

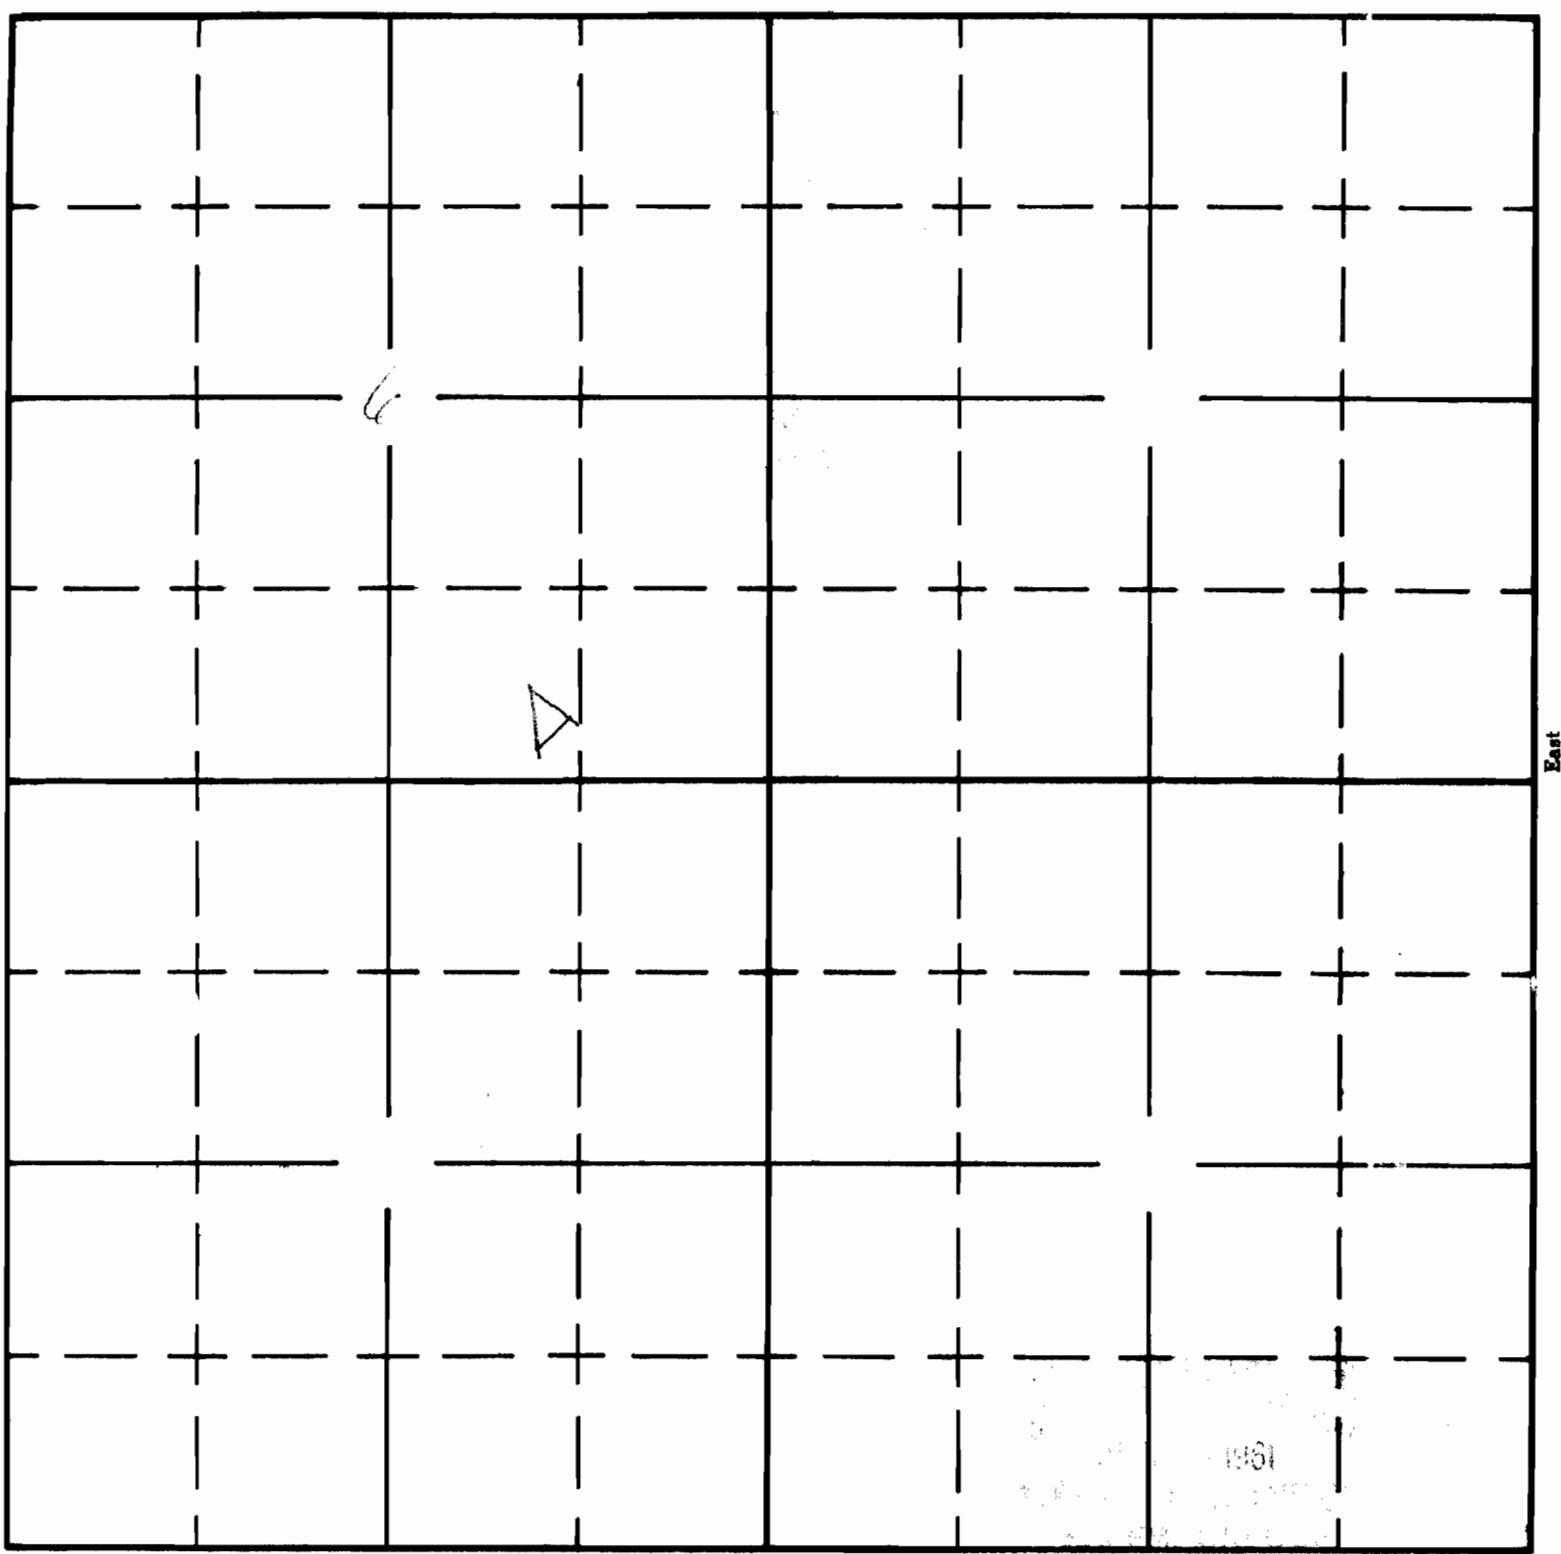

South

Times Peak Reservoir

APPLICATION No. R-36829
PERMIT No. R-3390