

Form AI-187
March 1961

UNITED STATES
DEPARTMENT OF THE INTERIOR
BUREAU OF LAND MANAGEMENT


SECTION

Oregon State Water Filings

TOWNSHIP 22S, RANGE 41E, W. M.

4
Stacy Res #1

North

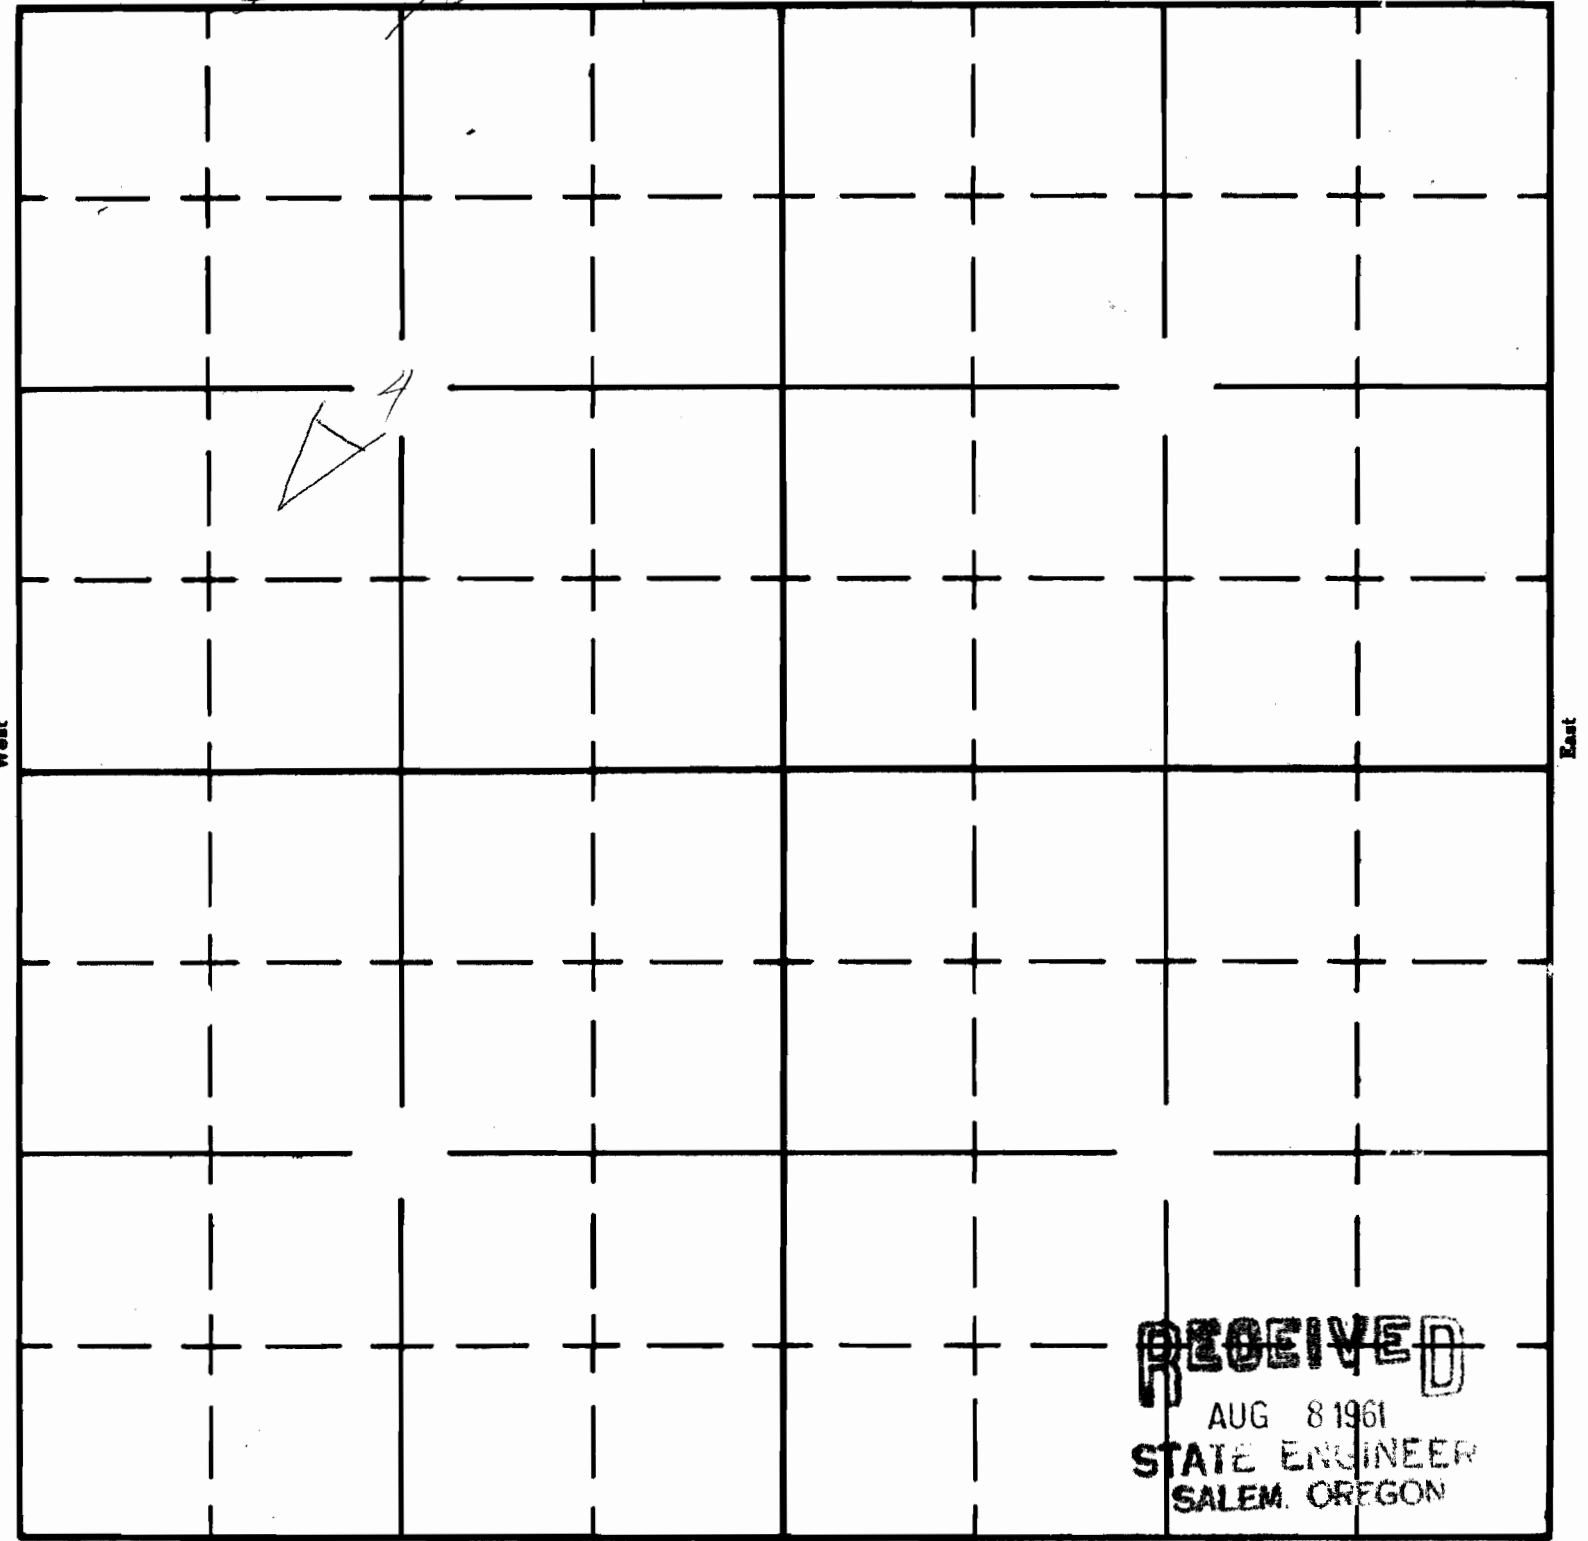

RECEIVED
AUG 8 1961
STATE ENGINEER
SALEM, OREGON

South

APPLICATION No. R-36862
PERMIT No. R-3827