

WATER RIGHT MAP FOR LOCATION CHANGE


RECEIVED

MAR 07 2002

WATER RESOURCES DEPT.
SALEM, OREGON

NW1/4 NE1/4 SEC 34 T 24S R 38E W.M.

U.S.G.S. QUAD - HICKEY BASIN, OREG. - 7 1/2'

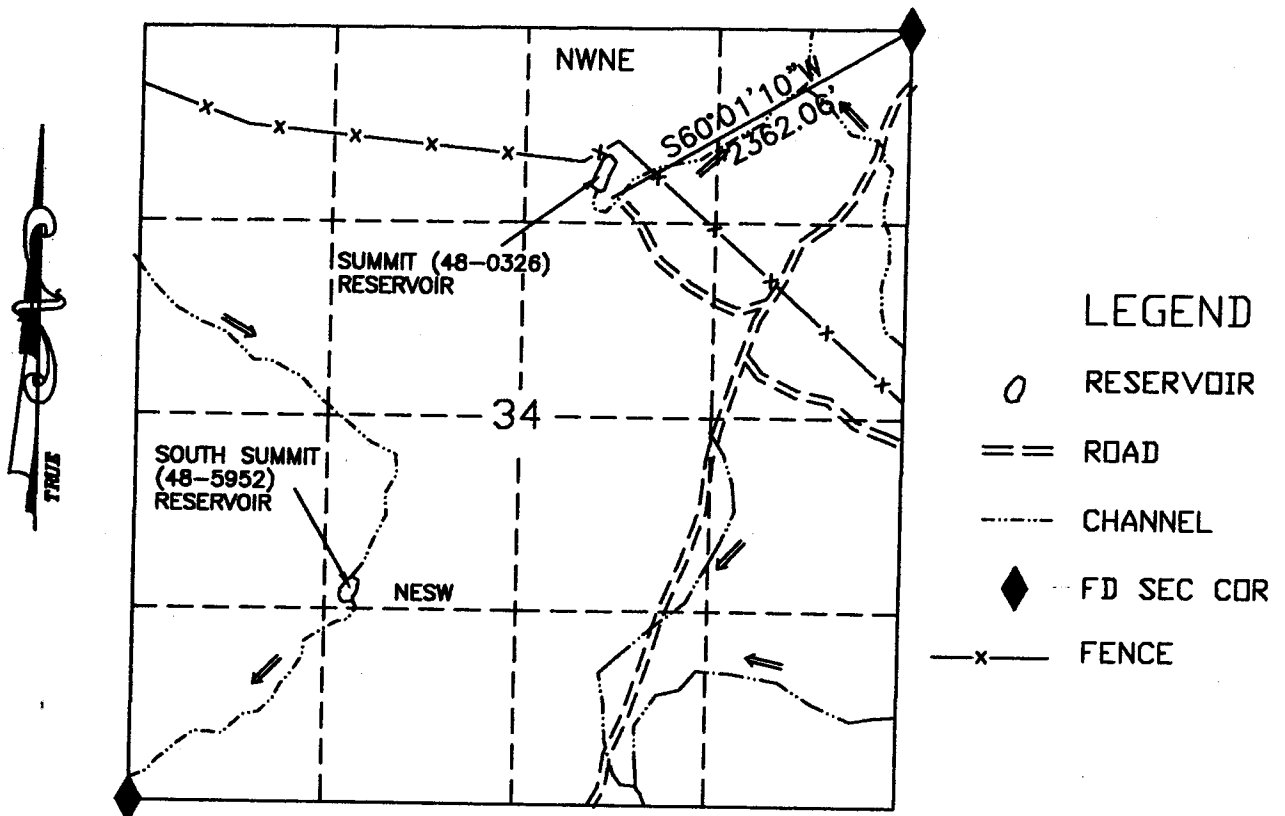

SUMMIT (48-0326) RESERVOIR



SCALE 1"=1320'

THIS MAP IS FOR THE PURPOSE OF LOCATING
A WATER RIGHT AND IS NOT INTENDED TO
PROVIDE LEGAL DIMENSIONS FOR LOCATION
OF PROPERTY BOUNDARIES.



ACAD2000
DWG FILE: SUMMITA.DWG

UNITED STATES DEPARTMENT OF THE INTERIOR BUREAU OF LAND MANAGEMENT DIVISION OF OPERATIONS VALE DISTRICT	
SUMMIT (48-0326) RESERVOIR	
DESIGNED _____	
REVIEWED _____	
APPROVED _____	CHIEF, BRANCH OF ENGINEERING
DRAWN: CG	SCALE: 1"=1320'
DATE: 02/14/02	SHEET 1 OF 1
DRAWING NO. DR-03-9172.45-1119	

Application No. R-36782
Permit No. R-7409