


UNITED STATES
DEPARTMENT OF THE INTERIOR
BUREAU OF LAND MANAGEMENT

SECTION 23

Oregon State Water Filings

TOWNSHIP 205, RANGE 49E, W. M.

North

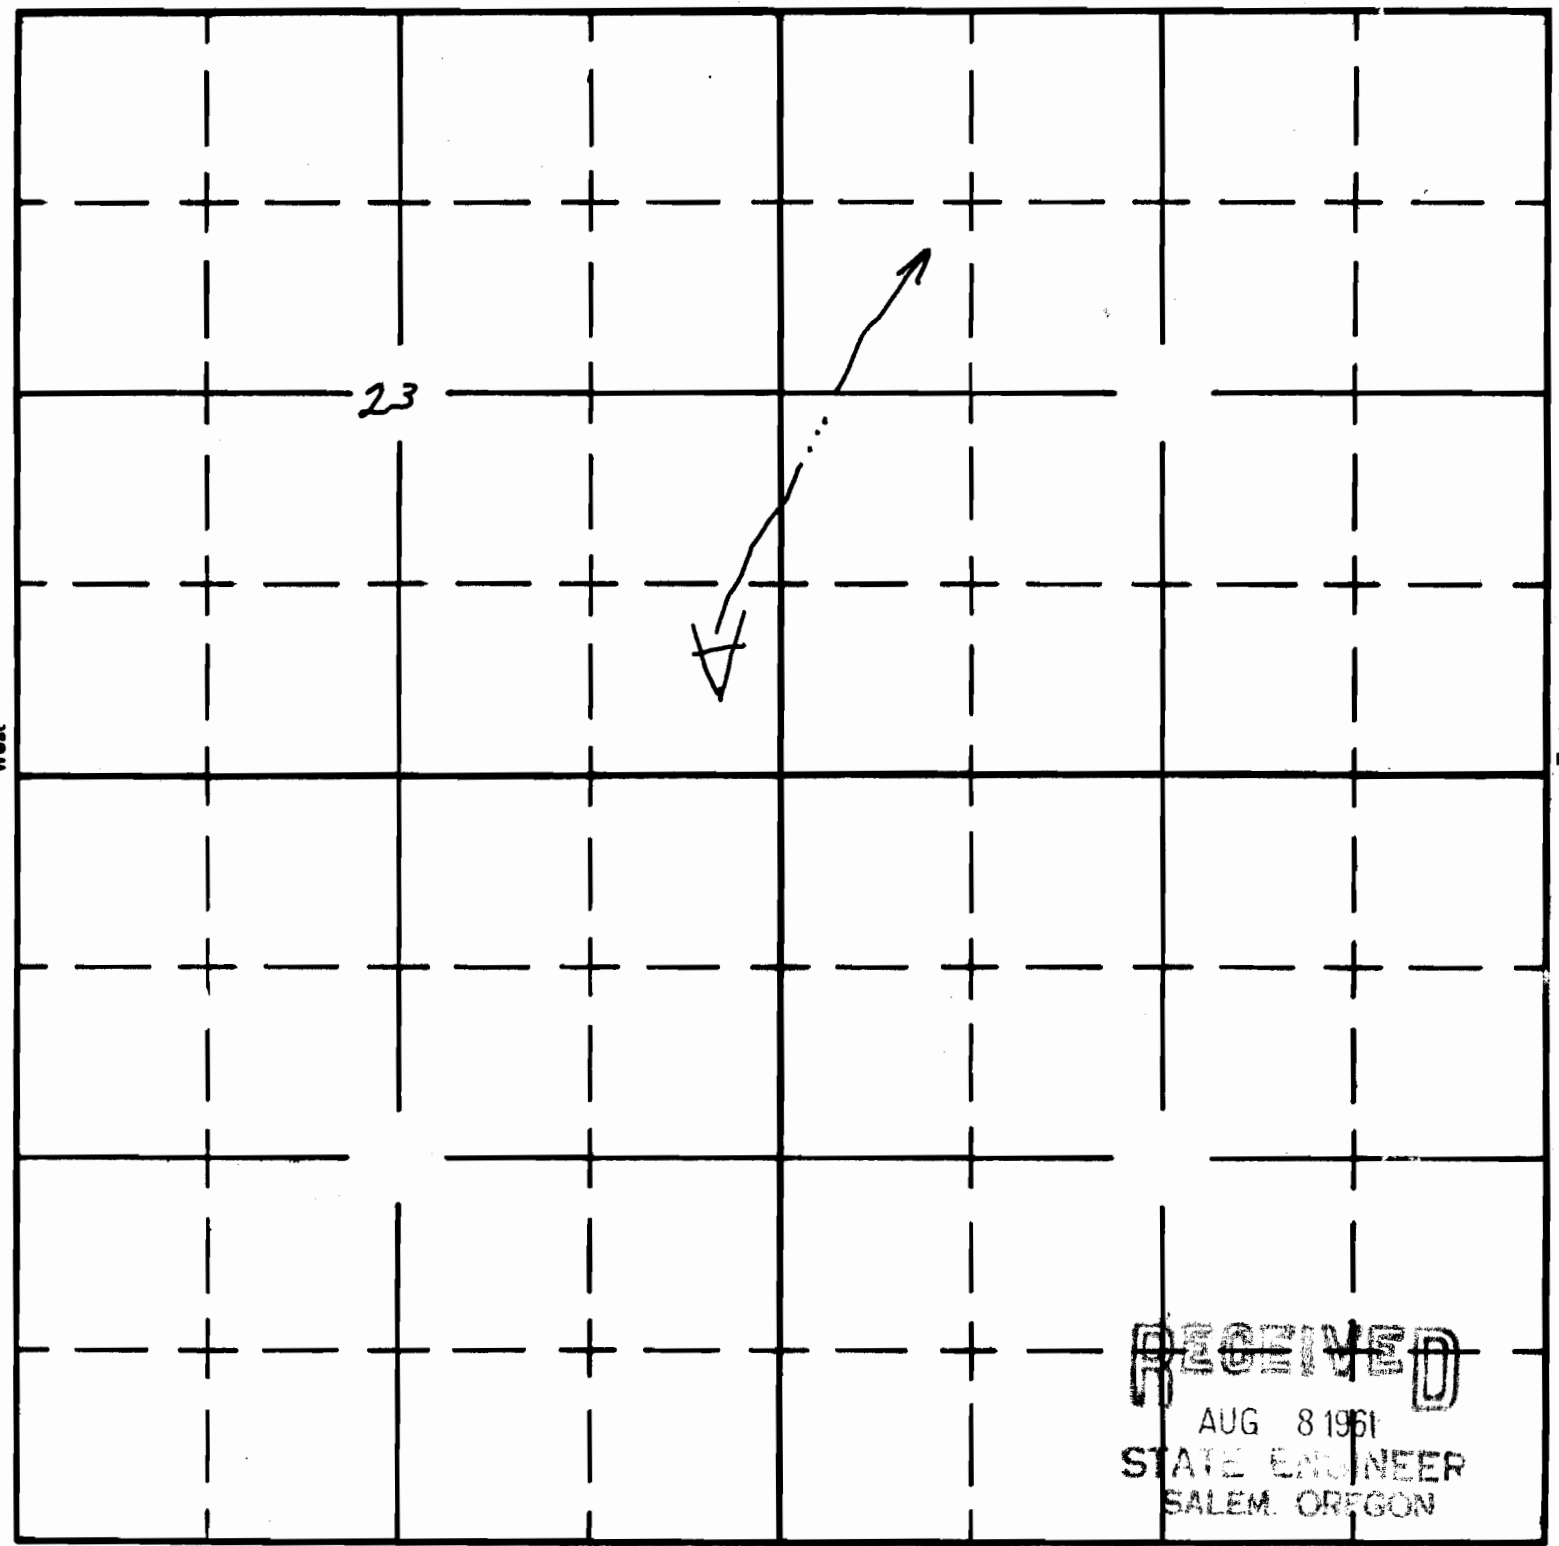

South

Two Forks Check Dam

APPLICATION No. **A-36875**
PERMIT No. **R-3831**

RECEIVED
AUG 8 1961
STATE ENGINEER
SALEM, OREGON