

UNITED STATES
DEPARTMENT OF THE INTERIOR
BUREAU OF LAND MANAGEMENT


SECTION _____

Oregon State Water Filings

2 TOWNSHIP 25S, RANGE 37E, W. M.

Vicks Res #1

North

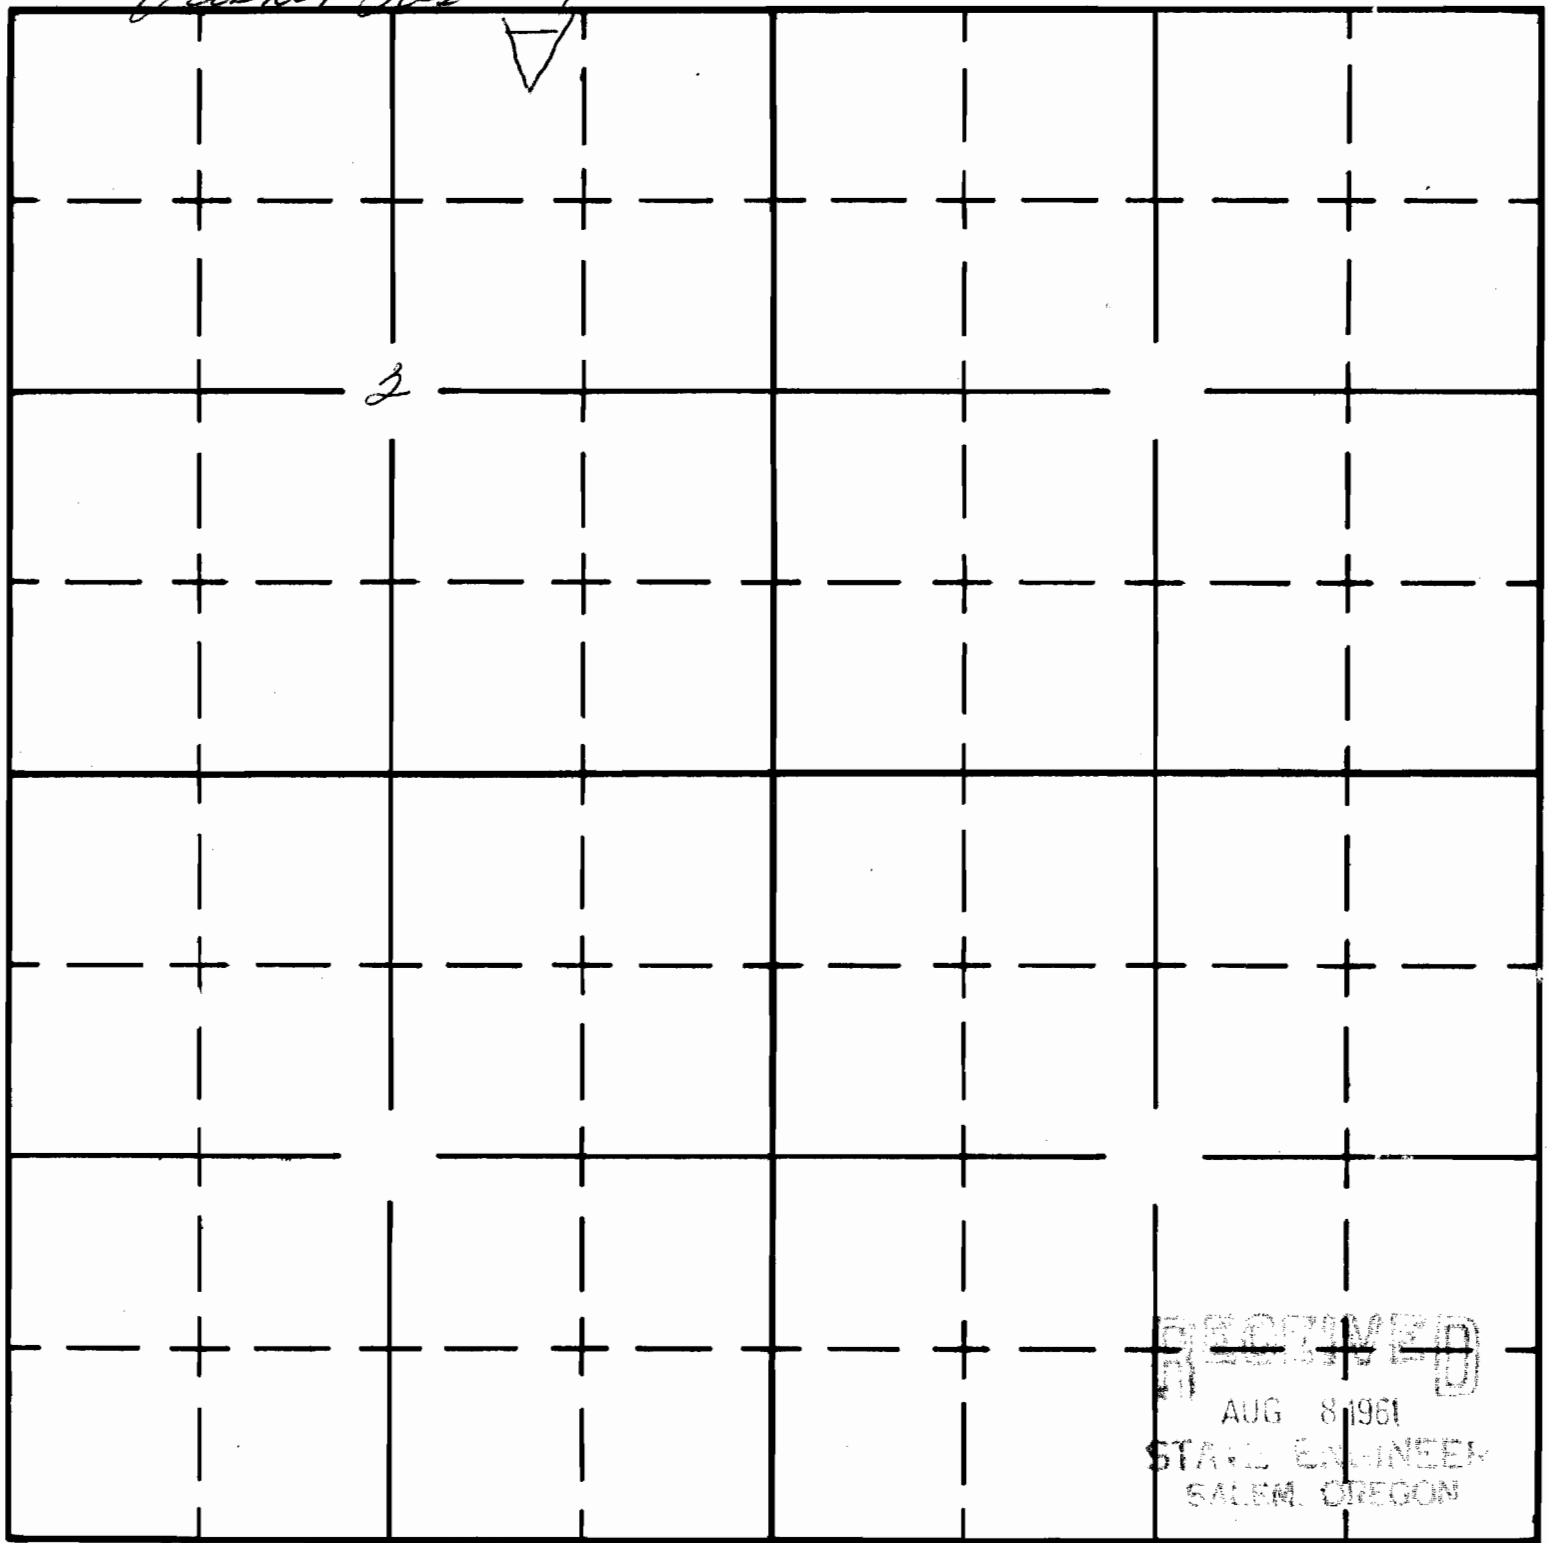

South

APPLICATION No. **R-36878**
PERMIT No. **R-3657**