

Form A1-187
March 1961

UNITED STATES
DEPARTMENT OF THE INTERIOR
BUREAU OF LAND MANAGEMENT

SECTION


33

SW⁴ NW⁴

Oregon State Water Filings

TOWNSHIP 36S., RANGE 42E., W. M.

North BLACK SAGE RESERVOIR

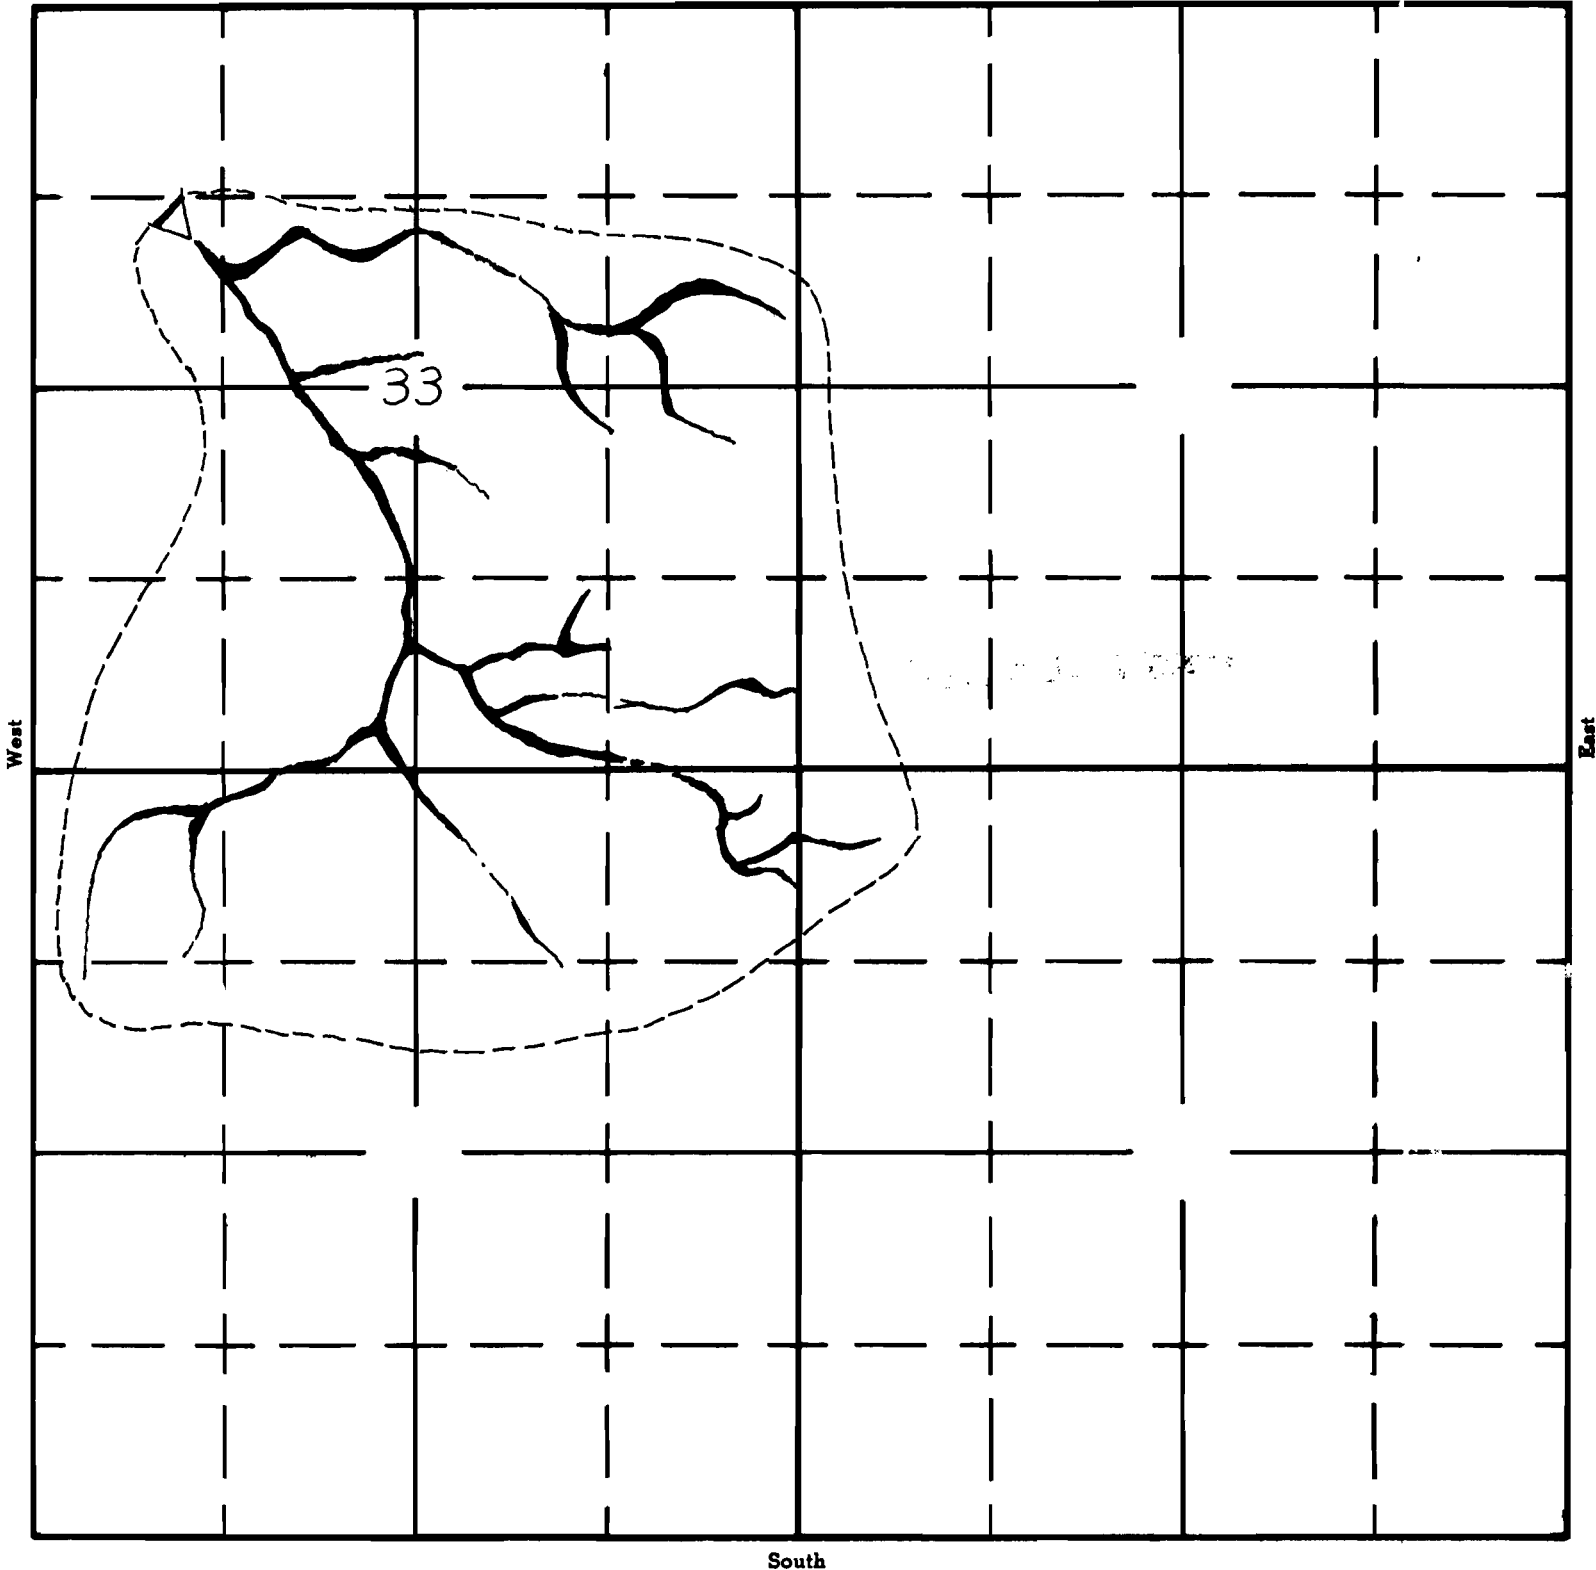

South

APPLICATION No. R-41481

PERMIT No. R-5189