

Form AI-187
March 1961

UNITED STATES
DEPARTMENT OF THE INTERIOR
BUREAU OF LAND MANAGEMENT

SECTION

Oregon State Water Filings


23

TOWNSHIP 37S, RANGE 45E, W. M.

NW⁴ SW⁴

North

GOAT CREEK RESERVOIR

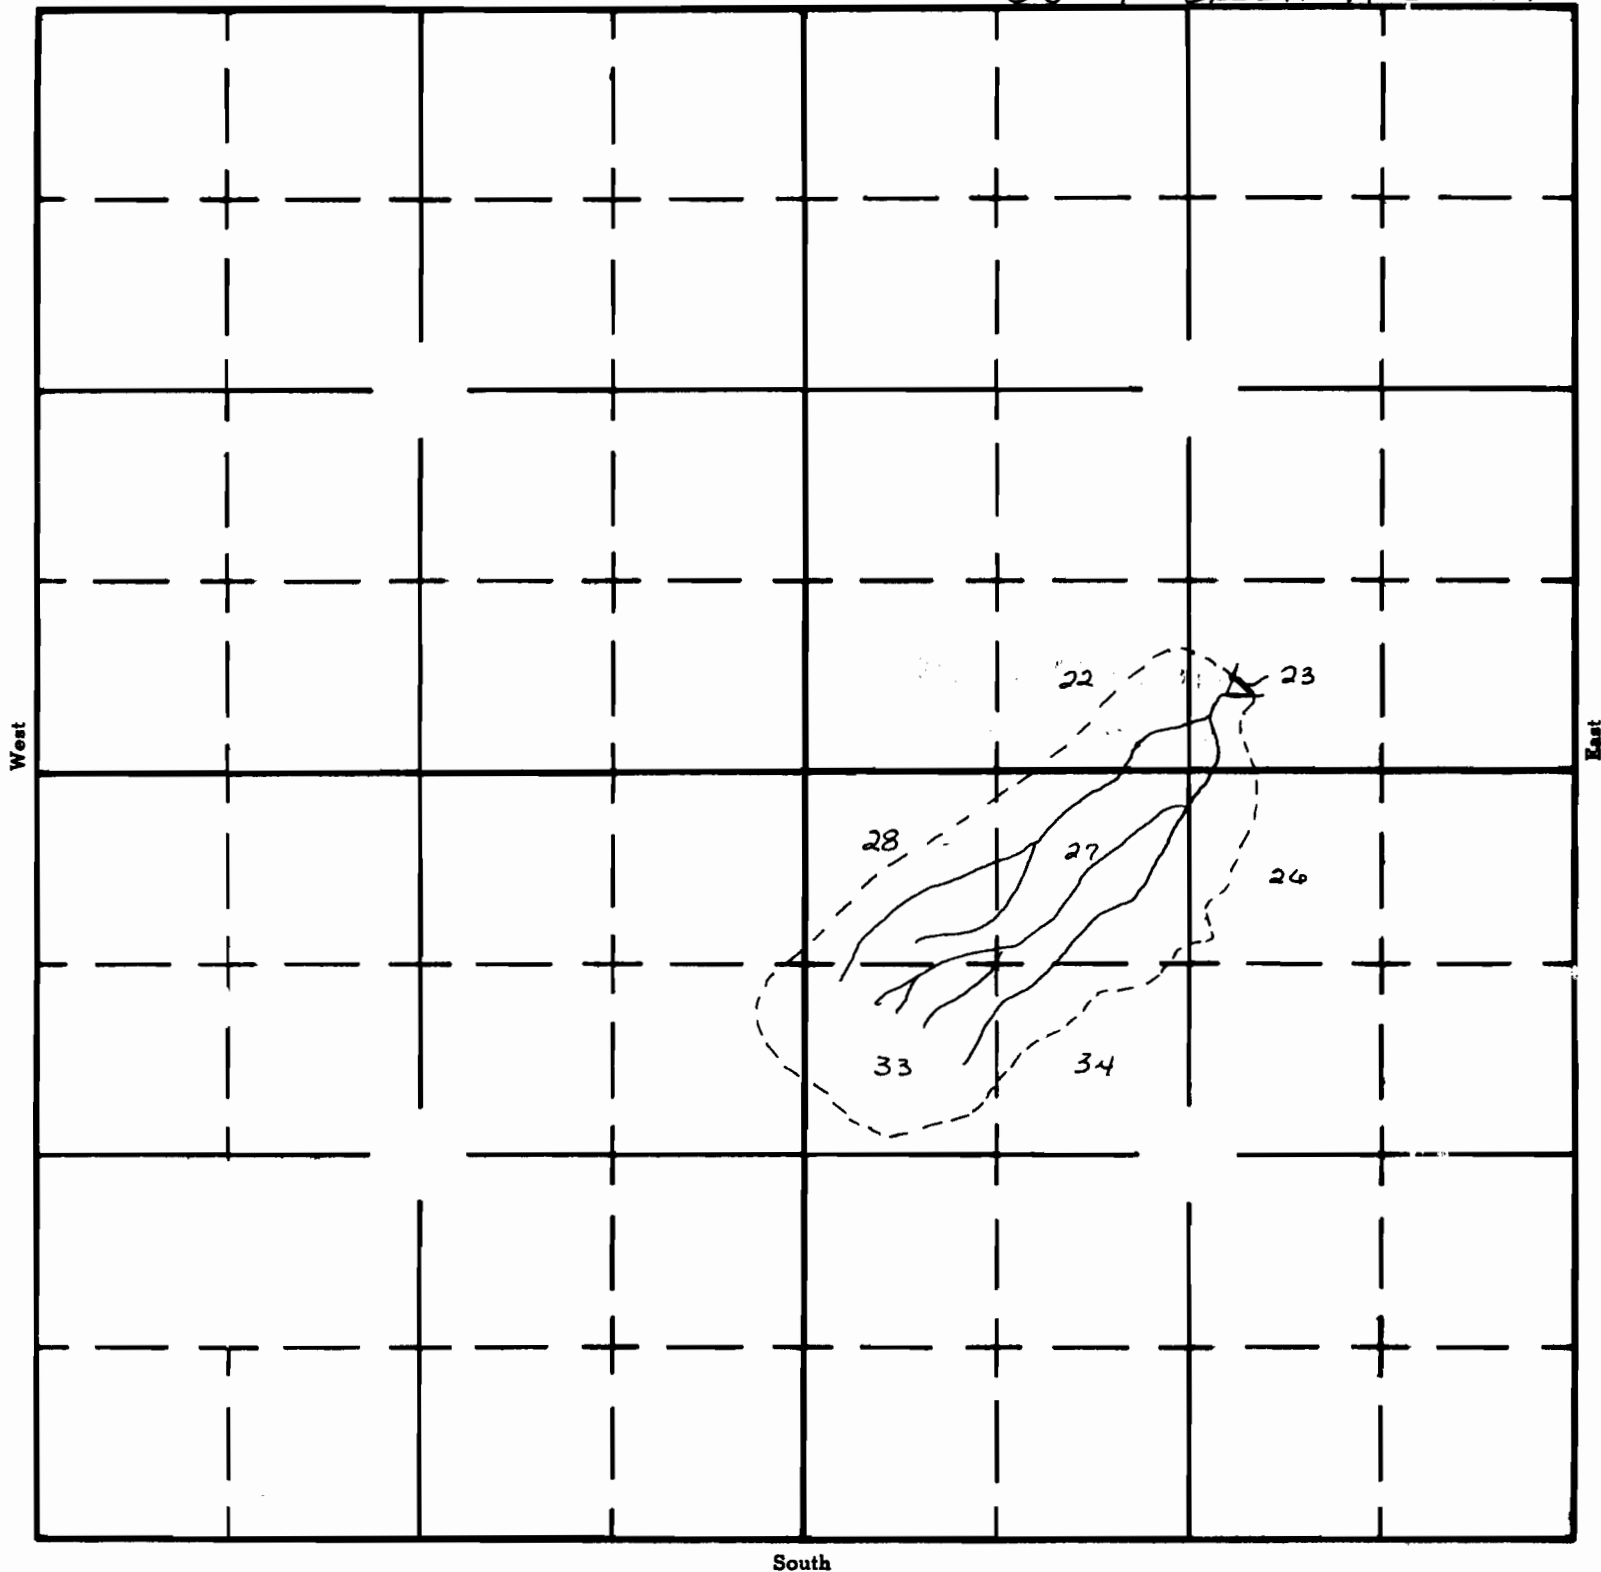

South

APPLICATION No. R-41487
PERMIT No. R-5195